F.3	.N.16010	
-----	----------	--

WATER SERVICE RECORD

Name Scott Properties	Service No.
Address 21 Circle Road	
Location	
Repair—Renewal—New Service	


				-	
Date	Material	Amount	Total	Date	Amoun
975	INSTALLED BY CONTR	ACTOR			
		_ 		- 	
	-		<u> </u>	#	
+	- 	 	 	 	
-		-, i	 	- ' 	
	: 		; ၨ+ 	<u> </u>	· · · · · · · · · · · · · · · · · · ·
ĺ	ļ	! !			ļ
			 		
		-	 	- 	
_			 	· · · · · · · · · · · · · · · · · · ·	
			'I : :	· 	
·			! !	·	· · · · · · · · · · · · · · · · · · ·
	1	!	i l	1	j
i			ļ		
		·- -	j —	'	
-		_ -	! 		
<u> </u>			ļ		· · · · · · · · · · · · · · · · · · ·
		_ _	L		
<u>-</u> - <u>-</u> - <u>-</u> - <u>-</u>		i — — — —			
			<u> </u>	#	
 -	·		 	<u> </u>	-
			· ÷— ·—— —	#	

_	A	~	_					

TOWN OF LEXINGTON - BOARD OF PUBLIC WORKS

WATER DIVISION

Sketch of Service Here

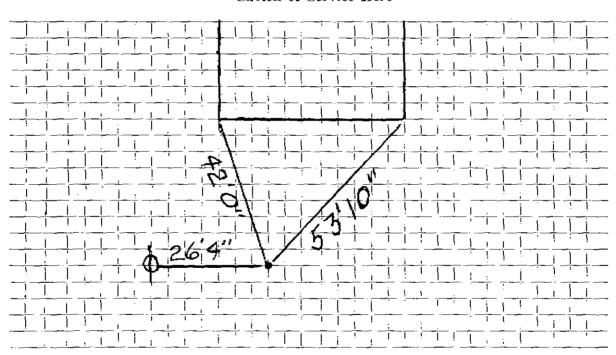

Connection made in	Street.	Work completed
Remarks:		