


TOWN OF LEXINGTON — BOARD OF PUBLIC WORKS

WATER DIVISION

Sketch of Service Here

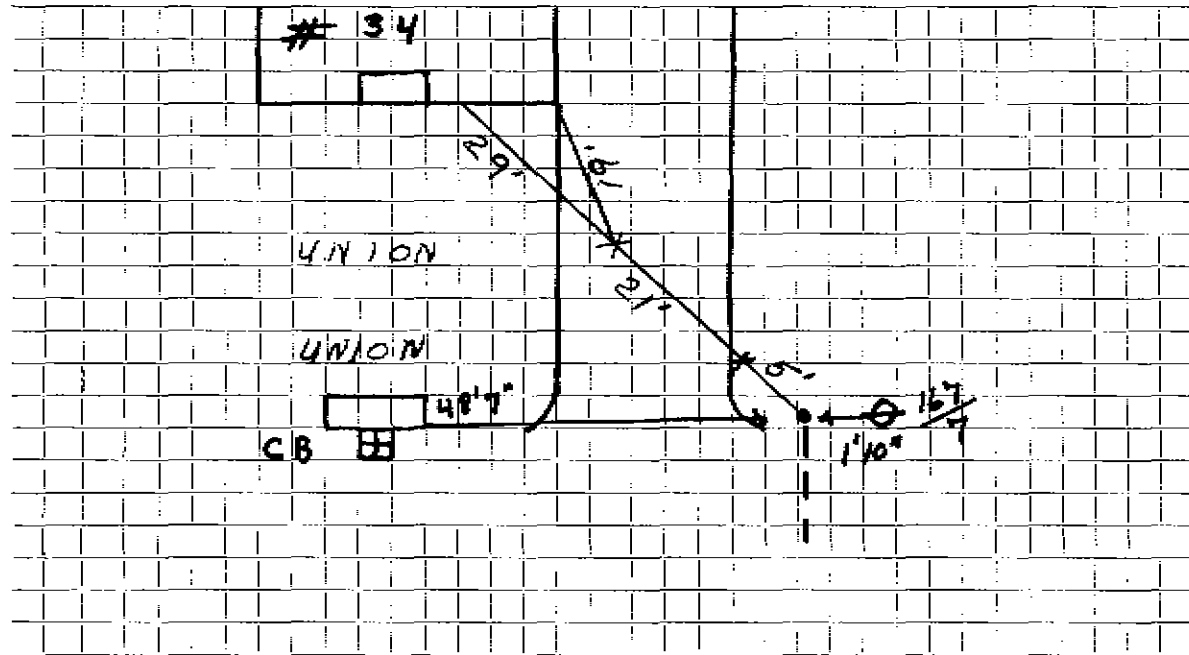

Connection made in Circle Rd. Street. Work completed

Remarks: To Edge of Rd. for 34 Circle Rd.

.....
.....