


DATE _____

TOWN OF LEXINGTON — BOARD OF PUBLIC WORKS
WATER DIVISION

Sketch of Service Here

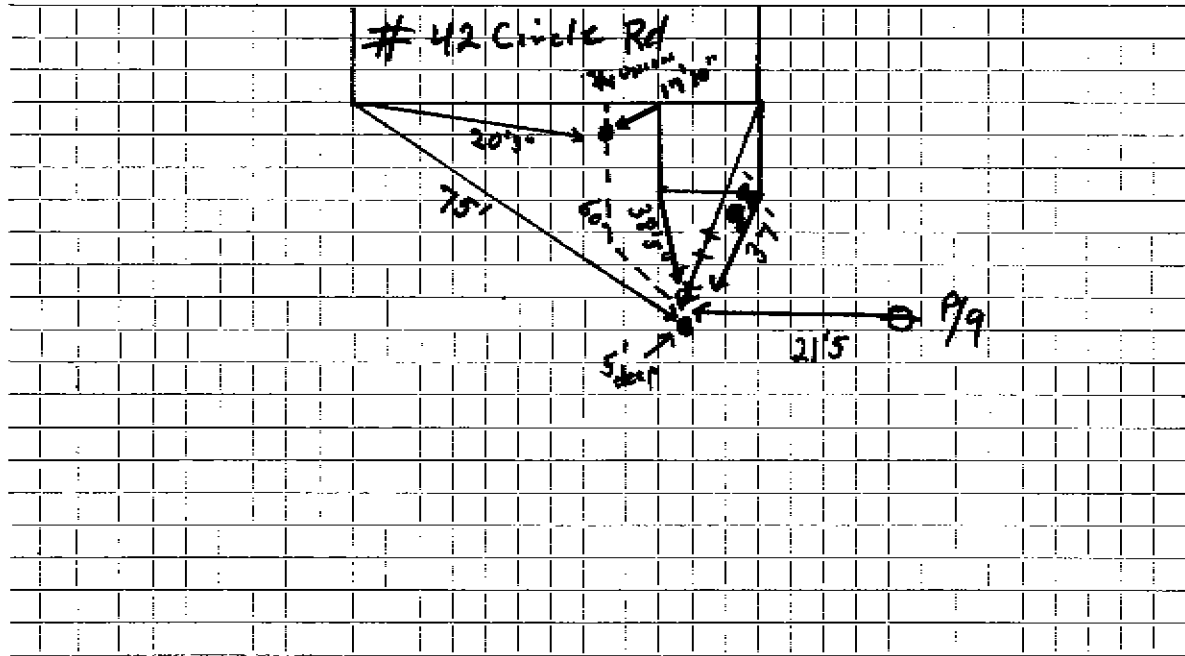

Connection made in Circle Rd Street. Work completed

Remarks: Water To Edge of Rd. No. Charge.

.....

.....