

WATER SERVICE RECORD

Name Antonio Busa

Service No.

Address 143 Circle Road

Location

Unit #7


~~Repair—Renewal—New Service~~

J.M. Luente Co. - Permit # A139

DATE _____

TOWN OF LEXINGTON — BOARD OF PUBLIC WORKS
WATER DIVISION

Sketch of Service Here

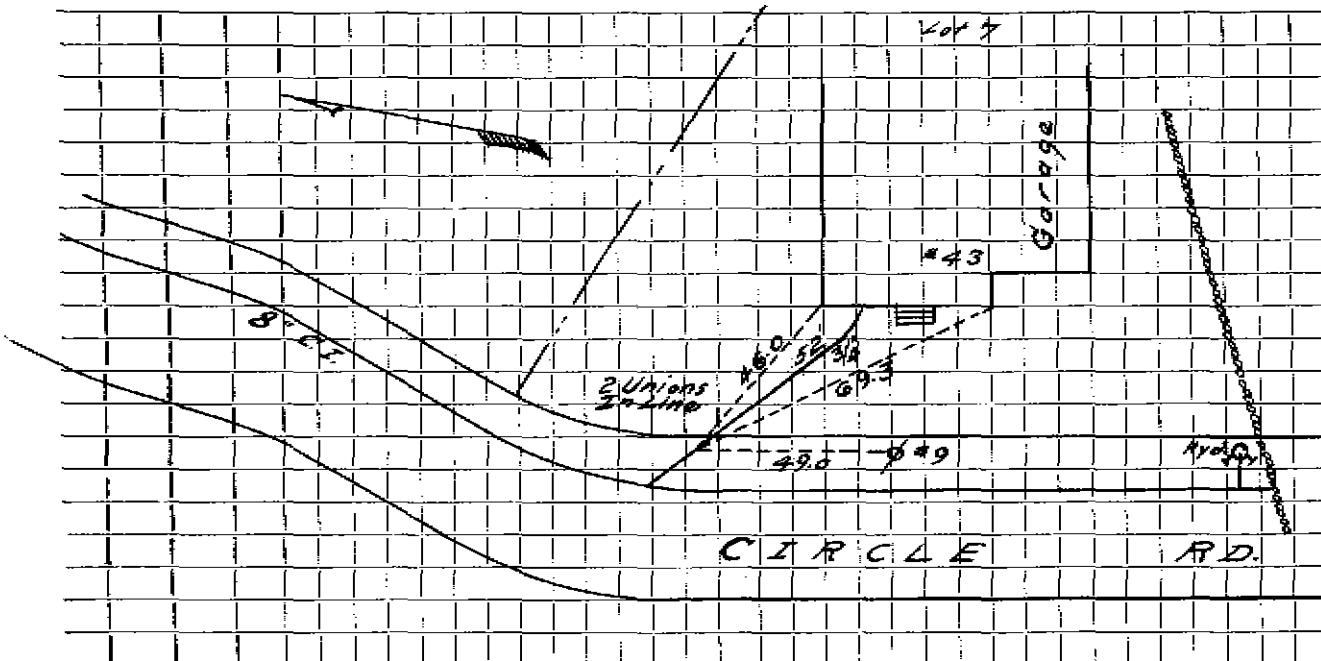

Connection made in Street. Work completed

Remarks:

.....

.....