

Name Howard W. Newell

Service No. 96

Address 12 Clarke Street

Lexington, Mass.

Location 12 Clarke Street

Kind of Pipe

Size

Size of Main

~~Repair - Renewal - New Service~~

Com. 8-23-48

Location

Date	Material	Amount	Total	Date	Amount
Jul. 6, 1948	Labor	27 65	27 65	June 21, '48	45 00
	10% Overhead		2 77	Aug 20 '48	1 50
	36' - 3/4" Copper Tubing @.255		9 18		43 50
	1 - 3/4" C x 1/2" I.W.H. S & W		3 15	Jul. 7, 1948	20 58
	Trucking 1 hr. @.75		75	10' - 3/4" Copper Tubing @.255	2 55
			43 50	1 - 3/4" C x 3/4" C Curb-cock	3 68
				1 - 3/4" C Adapter	1 44
				1 - Box & Rod	3 55
				1 - 1/2" Offset Tail Piece	30
				Trucking 1 hr. @.75	75
				Patching 7 x 3	7 00
					39 40

Shut of at Curb  
 11-74 JW  
 Curb was in driveway to house  
 Contractor pushed Curb box  
 below sidewalk  
 Labor

Deposited  
 Deposited  
 Non-Charge

Hadley Press, Inc., Lexington

DATE \_\_\_\_\_

# TOWN OF LEXINGTON—BOARD OF PUBLIC WORKS

## WATER DIVISION

The undersigned applies for a supply of water at No. \_\_\_\_\_ St. and hereby agrees to comply with the rules and regulations as now, or at any future time, established by the Board of Selectmen.

Am't. of Estimate \$ \_\_\_\_\_


Owner \_\_\_\_\_

Am't. Paid \$ \_\_\_\_\_

Address \_\_\_\_\_

Builder \_\_\_\_\_

Sketch of Service Here

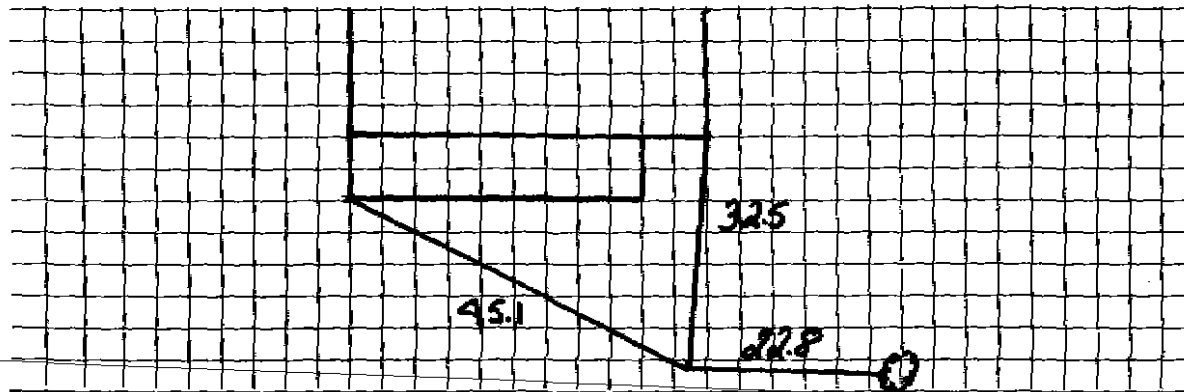

Connection made in \_\_\_\_\_ Street.

Work completed \_\_\_\_\_ 19

Remarks:

Name Howard W. Newell

Service No.

Address 12 Clarke Street

Lexington, Mass.

Location 12 Clarke Street

Kind of Pipe

Size

Size of Main

~~Repair—Renewal—New Service~~

Com. 8-23-48

Location

Date

Material

Amount

Total

Date

Amount

Jul. 6, 48

Labor

27 65

27 65

10% Overhead

2 77

35' - 3/4" Cooper Tubing @ .255

9 18

1 - 3/4" C x 1/2" I. S. S

3 15

Trucking 1 hr. @ .75

75

43 50

*Shot of at Curb*

*11-74 JW*

*Curb was in driveway to house*

*Contractor pushed Curb down*

*below sidewalk*

Labor

*June 21, 48*  
*Aug 20 48*

*Deposited*  
*Refunded*  
Non-Charge

45 00

1 20

43 50

Jul. 7, 48

Labor

20 78

10' - 3/4" Cooper Tubing @ .255

2 55

1 - 3/4" C x 1/2" Curb-cock

3 68

1 - 3/4" - Adaptor

1 04

1 - Box & Rod

3 55

1 - 3" Offset Tail Piece

30

Trucking 1 hr. @ .75

75

Patching 7 x 3

7 00

39 60

DATE \_\_\_\_\_

# TOWN OF LEXINGTON—BOARD OF PUBLIC WORKS

## WATER DIVISION

The undersigned applies for a supply of water at No. \_\_\_\_\_ St. and hereby agrees to comply with the rules and regulations as now, or at any future time, established by the Board of Selectmen.

Am't. of Estimate \$ \_\_\_\_\_


Owner \_\_\_\_\_

Am't. Paid \$ \_\_\_\_\_

Address \_\_\_\_\_

Builder \_\_\_\_\_

Sketch of Service Here

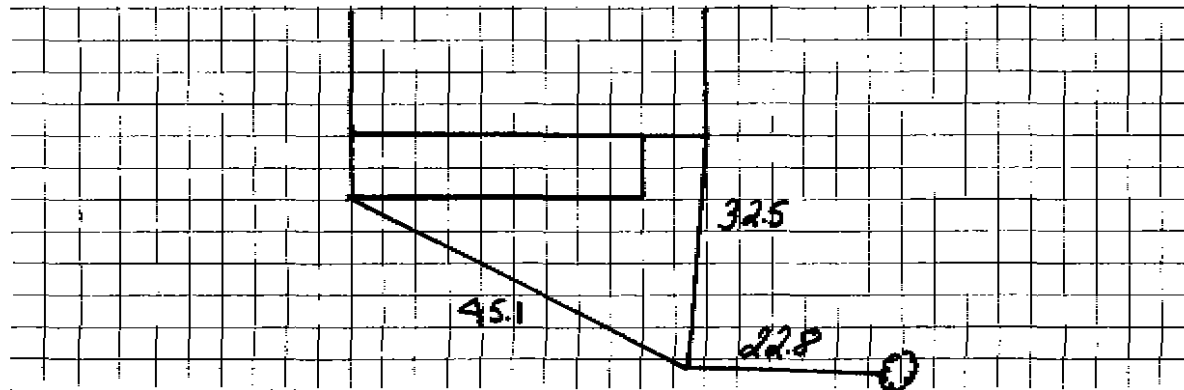

Connection made in \_\_\_\_\_ Street.

Work completed \_\_\_\_\_ 19

Remarks: