




DATE \_\_\_\_\_

**TOWN OF LEXINGTON — BOARD OF PUBLIC WORKS**

**WATER DIVISION**

*Sketch of Service Here*

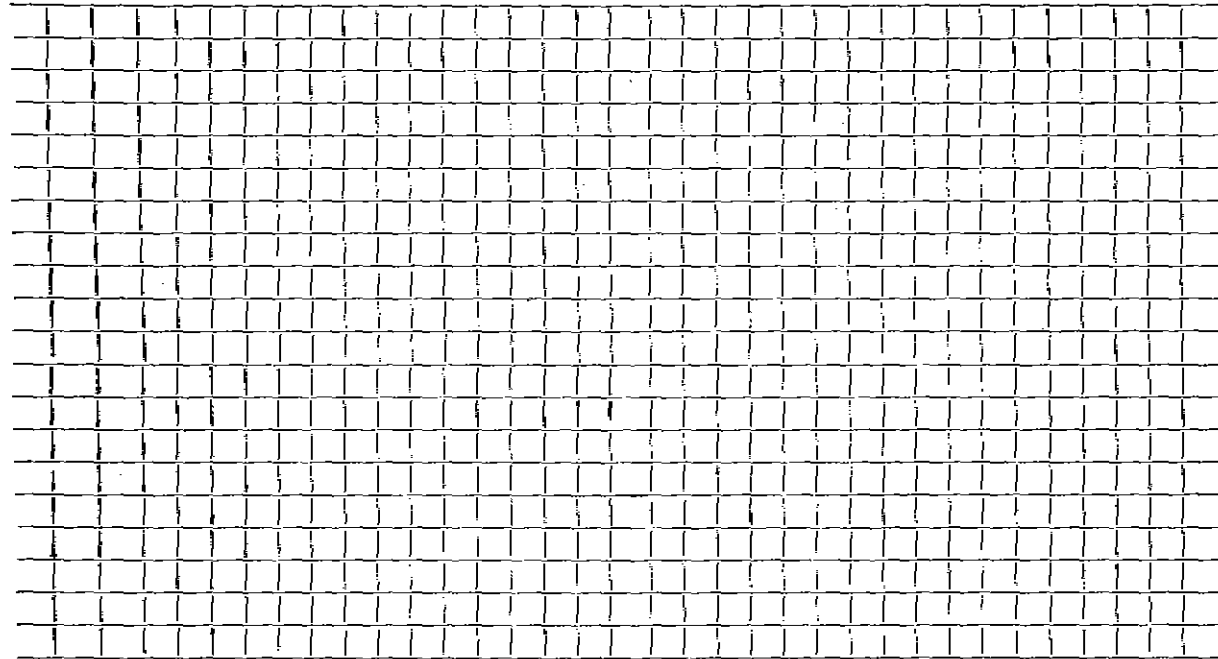

Connection made in ..... Street. Work completed .....

Remarks: .....

.....

.....