

WATER SERVICE RECORD

5787

Name Tilfer Construction Company

Service No. 73

Address 16 Clarke Street

Location

Repair—Renewal—New Service

Comm. 11-18-57


Date	Material	Amount	Total	Date	Amount
5/20/57	Labor	19 04		4-18-57	Deposit \$ 150 00
	10% overhead	1 90	20 94	11-18-57	Refund 48 61
	45' - 1 1/2" Copper tubing @ .91		40 95		\$ 101 39
	1 - 1 1/2" Jenkins Comp. Valve		15 84		NON CHARGE
	1 - 1 1/2 x 1 1/2 Female Coupling		5 40	Labor	10 88
	1 - 1 1/2 x 2 1/2 Long Space Nipple		1 01	15' - 1 1/2" Copper tubing @ .91	13 65
	1 - 1 1/2 x 4" Long Space Nipple		1 50	1 8" x 1 1/2" Cast Iron Saddle	2 50
	15x3 Patch		15 00	1 - 1 1/2" Brass Close Nipple	1 50
	1 hr. trucking		75	1 - 1 1/2" Brass Nipple	1 25
			101 39	1 hr. Trucking	75
				1 1/2 hrs. Town Shovel @ 6.50	9 75
					40 28

DATE _____

TOWN OF LEXINGTON — BOARD OF PUBLIC WORKS

WATER DIVISION

Sketch of Service Here

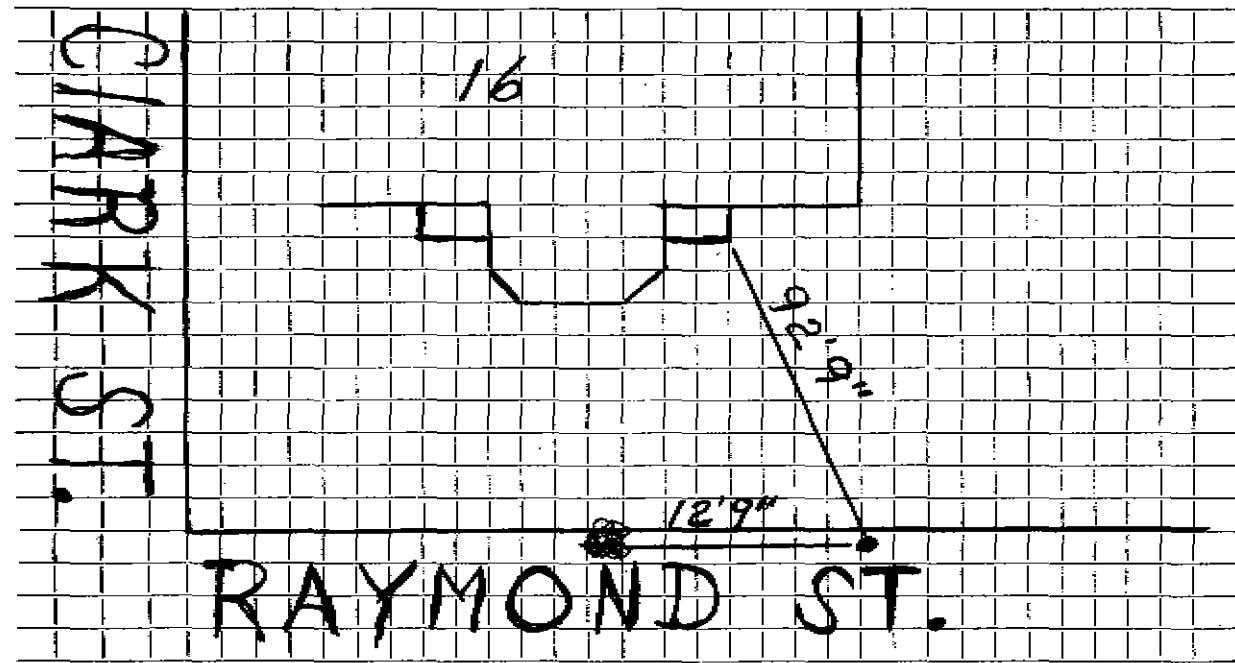

Connection made in Street. Work completed

Remarks: *Date on old card 4/8/40*

.....
.....