



DATE 7/11/90


TOWN OF LEXINGTON — BOARD OF PUBLIC WORKS

P.A.B.

WATER DIVISION

Sketch of Service Here

← FRONT OF HSE.

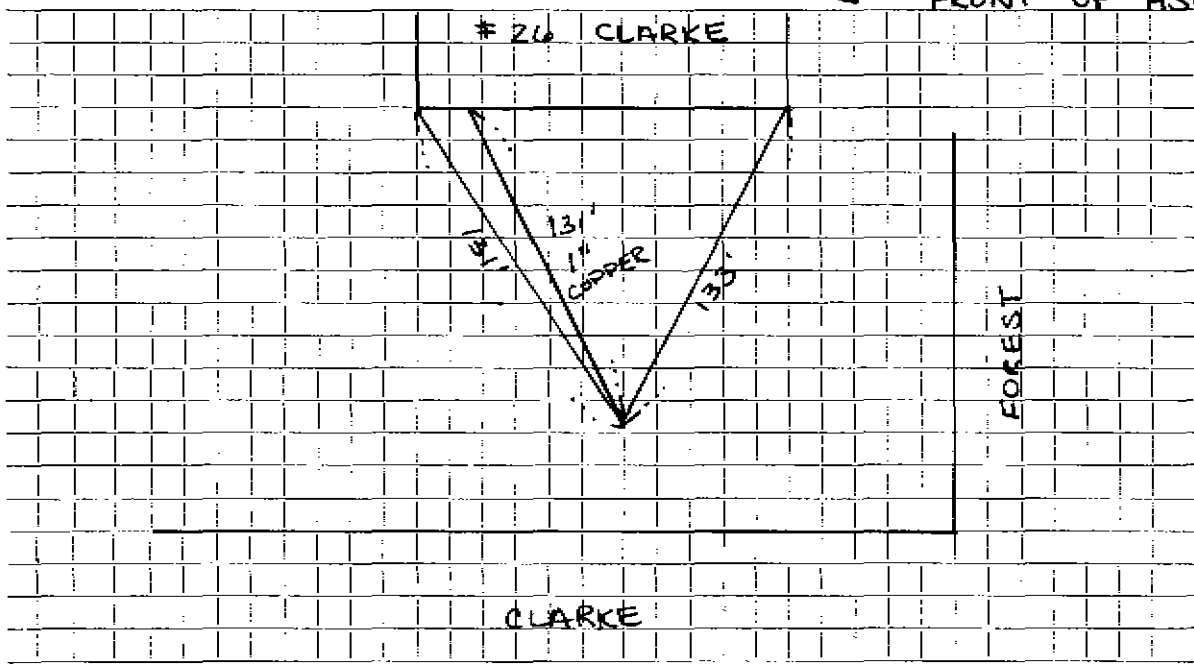

Connection made in CLARKE Street. Work completed

Remarks: INSPECTED: P.A. BARROWS

CONTRACTOR: J. MCLAUGHLIN