


DATE 10/19/12

TOWN OF LEXINGTON — BOARD OF PUBLIC WORKS

WATER DIVISION

Sketch of Service Here

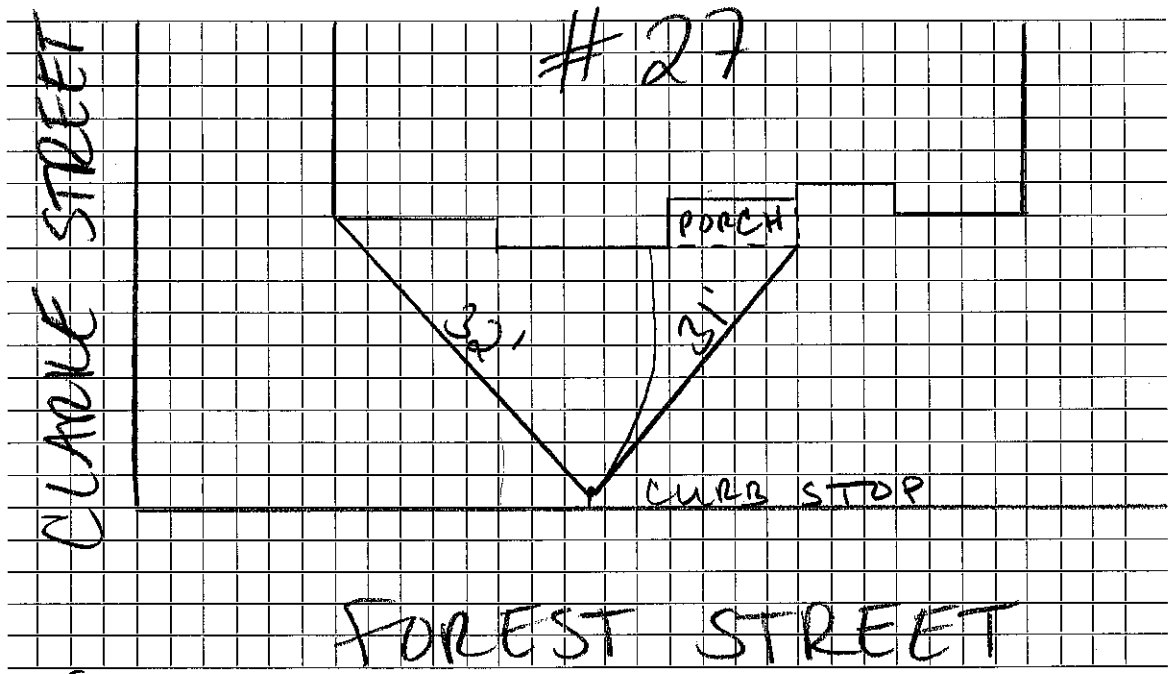

Connection made in Forest Street. Work completed

Remarks: House #27 Clarke St