




DATE \_\_\_\_\_

TOWN OF LEXINGTON — BOARD OF PUBLIC WORKS

**WATER DIVISION**

Sketch of Service Here

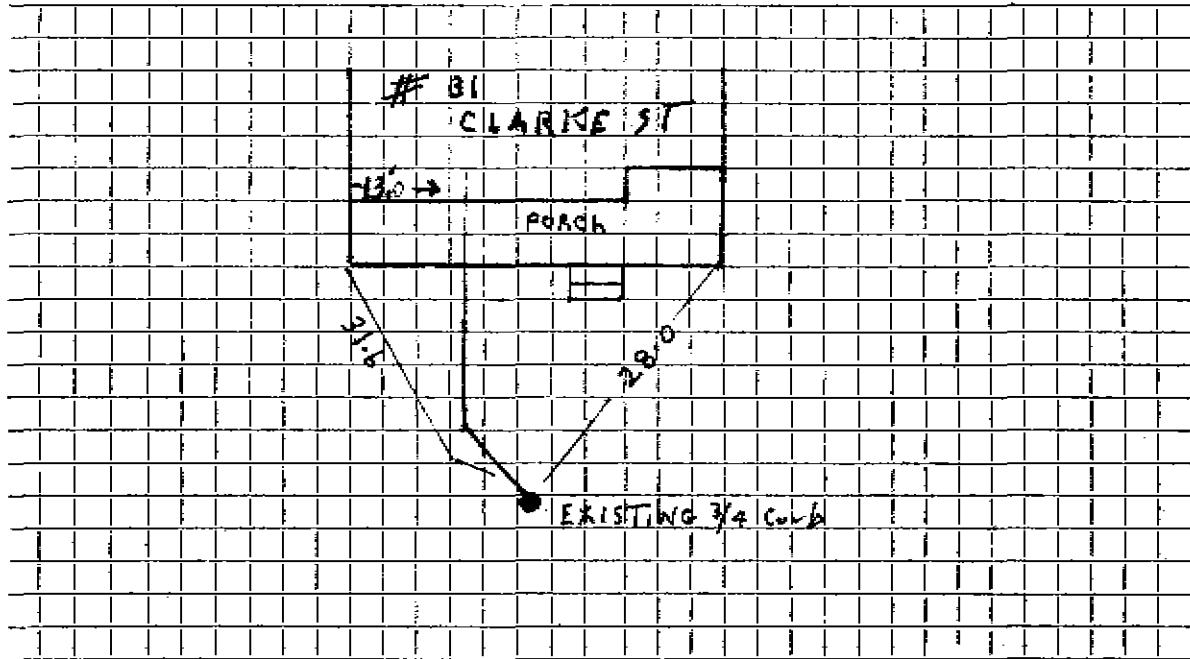

Connection made in ..... Street. Work completed 12/5/02 .....

Remarks: .....

.....

.....

Name Miss Elizabeth K. Buckley

Service No. ~~12~~ 570

Address 31 Clarke Street

Lexington 73, Mass.

Location 31 Clarke Street

3009  
#7065,7145

Kind of Pipe

Size

Size of Main

~~Repair~~ ~~Renewal~~ ~~New Service~~

Location

Date	Material	Amount	Total	Date	Amount
Sept. 28, '44	Labor	31 50	31 50	Sept 21, 44	55 00
	10% Overhead		3 15	Oct 19, 44	8 80
	8'- $\frac{3}{4}$ " Copper Tubing @.19		1 52		46 20
	27'-1" C.L. Pipe @.30		6 75		
	1-1" I x $\frac{3}{8}$ " I.L.H. Stop & Waste		2 53		
	1 hr. Trucking @.75		75		
			46 20		
	Labor				

*Deposited*  
*Refunded*

Hadley Press, Inc., Lexington

DATE \_\_\_\_\_

# TOWN OF LEXINGTON—BOARD OF PUBLIC WORKS

## WATER DIVISION

The undersigned applies for a supply of water at No. \_\_\_\_\_ St. and hereby agrees to comply with the rules and regulations as now, or at any future time, established by the Board of Selectmen.

Am't. of Estimate \$ \_\_\_\_\_


Owner \_\_\_\_\_

Am't. Paid \$ \_\_\_\_\_

Address \_\_\_\_\_

Builder \_\_\_\_\_

Sketch of Service Here

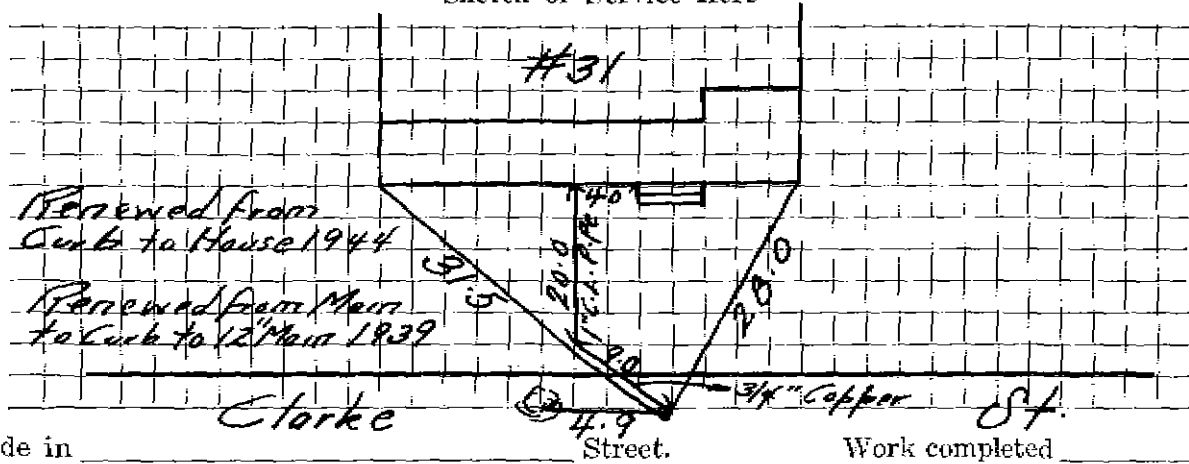

Connection made in \_\_\_\_\_

Remarks: