

## WATER SERVICE RECORD

Name

Service No.

Address

34 Clarke Street

Location

~~Repair—Renewal—New Service~~ W.O. #1006. (outside)


Date	Material	Amount	Total	Date	Amount
7-12-73	Labor	114.48			
7-19-73	Labor	43.85	\$158.73		
	12 <sup>1</sup> 3/4" Copper @.60		7.20		
	1 3/4" Corporation		9.57		
	1 3/4" 3 Part Union		3.87		
	1 Ton Top		8.00		
	1/2 Ton Cold Patch		6.10		
	3 Hrs. Trucking				
	1 Hr. Pick up				
	1 Hr. Roller				
	2 Hrs. Town Shovel				
	1 Hr. Compressor				
	1 Hr. Loader				
Com. S.A.S	Renewal of H <sub>2</sub> O service pipe driven underground		30 00		

DATE \_\_\_\_\_

TOWN OF LEXINGTON — BOARD OF PUBLIC WORKS

**WATER DIVISION**

Sketch of Service Here

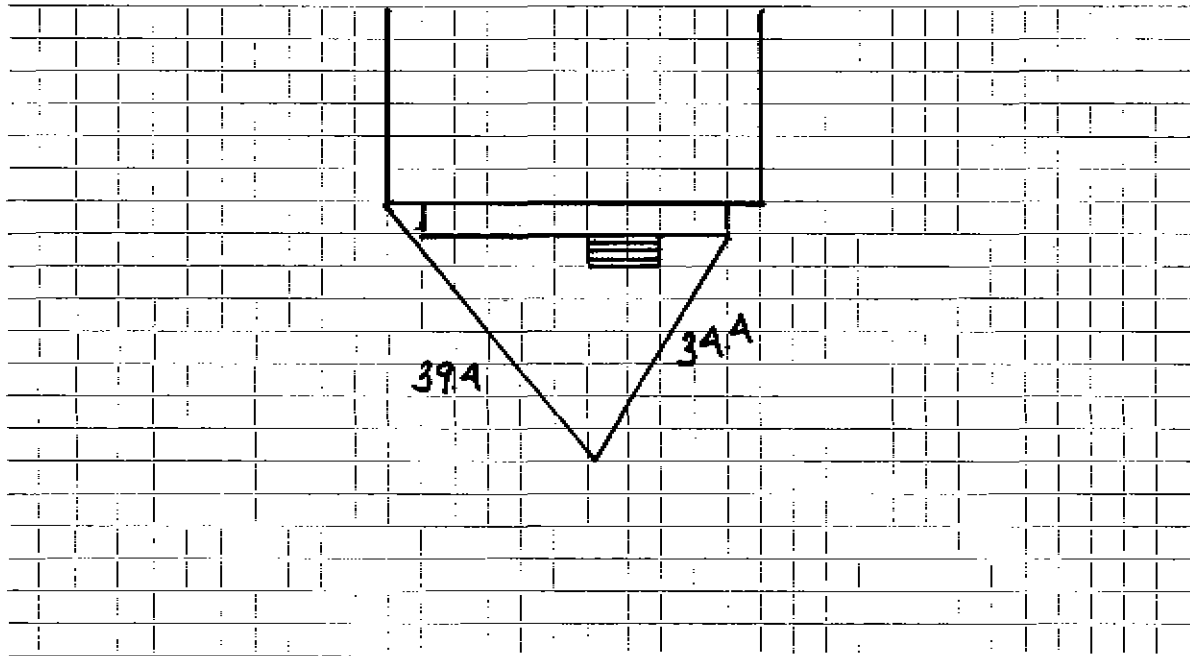

Connection made in ..... Street. Work completed .....

Remarks: .....

.....

.....