

Name Philip Perry

Service No.

572

Address 35 Clarke Street

Lexington, Mass.

Location 35 Clarke Street

Kind of Pipe

Size

Size of Main

Repair—Renewal—New Service

Location

Date	Material	Amount	Total	Date	Amount
Jul. 17, '47	Labor	3 08	3 08	July 7 '47	20 00
	10% Overhead		31	Sept 25 '47	3 26
	35' - 3/4" Copper Tubing @ .27	9 45	9 45		16 74
	1 - 3/4" 3 x 3/4" I.W.K. S & W	3 15	3 15	Jul. 8, '47	9 07
	Trucking 1 hr. @ .75	75	75	1 - 3/4" 3 x 1" I Union (2 pts)	87
			16 74	1 - 3/4" Offset Tail Piece	30
					10 24
				15' 1" Copper tubing @ .56	8 40
				1 1" C Corp Cock	10 66
				2 Hrs Town Shovel @ .50	13 00
				2 Hrs Trucking @ 3.00	6 00
	Labor			15 x 3 Patch	15 00
					53 06

Deposited
Refunded
Non-charge

TOWN OF LEXINGTON - BOARD OF PUBLIC WORKS

WATER DIVISION

The undersigned applies for a supply of water at No..... St. and hereby agrees to comply with the rules and regulations as now, or at any future time, established by the Board of Selectmen.

Am't of Estimate \$.....

Owner


Am't Paid \$.....

Address

Builder

.....

Sketch of Service Here

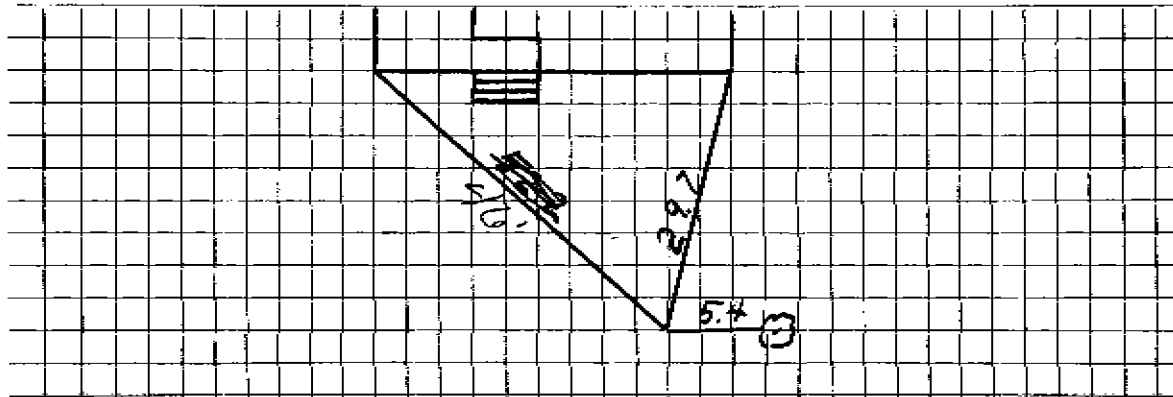

Connection made in Street.

Work completed19

Remarks: