



DATE

TOWN OF LEXINGTON — BOARD OF PUBLIC WORKS


### WATER DIVISION

Sketch of Service Here

FOREST ST

PARMER ST

CLARK ST  
1/2" C.I.

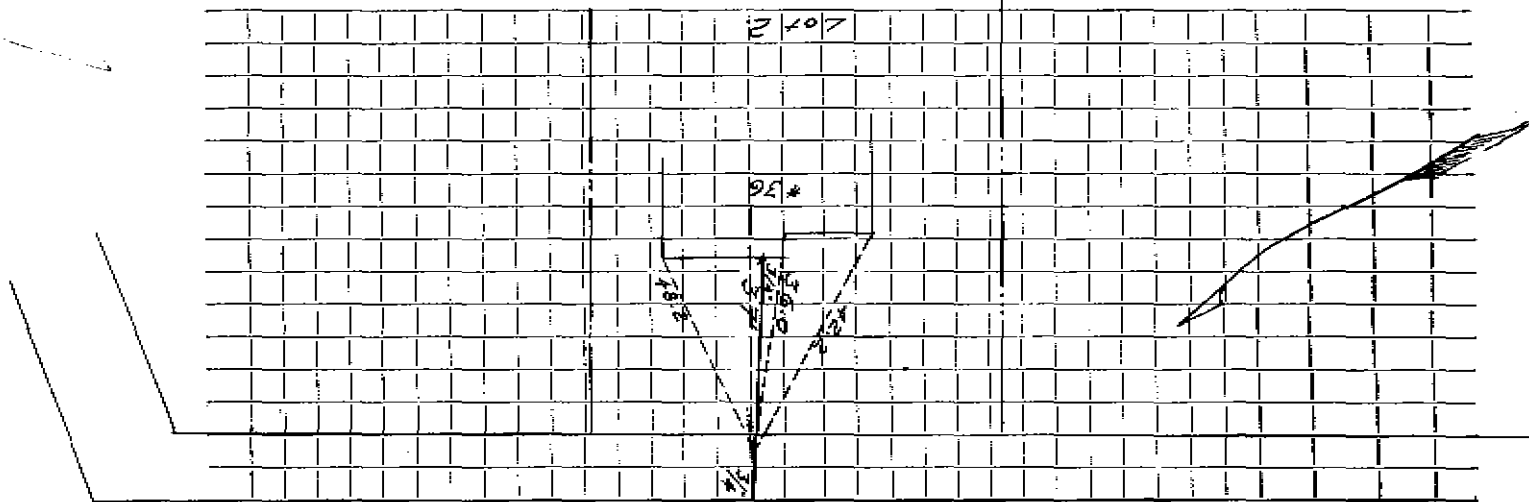

Connection made in Street. Work completed

Remarks: