

Name Frank W. Friend
 Address 39 Clarke St.

Service No. # 573
 313 1

Location

Kind of Pipe

Size

Size of Main

~~Repair - Renewal - New Service~~ Miscel.

Location

Date	Material	Amount	Total	Date	Amount
Comm. 27 - 8-16-32	37' 1" Copper Pipe @.26	\$9 62		Aug 3	20 00
	1 1" C. to I. Ell.	1 30		20	7 00
	1 1" C. to I. Union	80			27 00
	1 S & W	3 00			
	Trucking	75	\$18 47		
8/6/32	7 Hrs. Labor @.55	3 85			
	3 " " @.60	1 80	5 65		
	15% Overhead		85		
	<u>COST</u>		21 97		
	<u>CHARGE</u> 37' @ .75-\$27.75, but				
	Est. given was	\$27 00	\$27 00		

Aug 3 Cash
20

20 00
 7 00
 27 00

Hadley Press, Inc., Extington

DATE June 6, 1932

TOWN OF LEXINGTON—BOARD OF PUBLIC WORKS

WATER DIVISION

The undersigned applies for a supply of water at No. 39 Clarke St. and hereby agrees to comply with the rules and regulations as now, or at any future time, established by the Board of Selectmen.

Am't. of Estimate \$ 27


Owner Frank W. Friend

Am't. Paid \$ 20

Address 39 Clarke St.

Builder _____

Sketch of Service Here

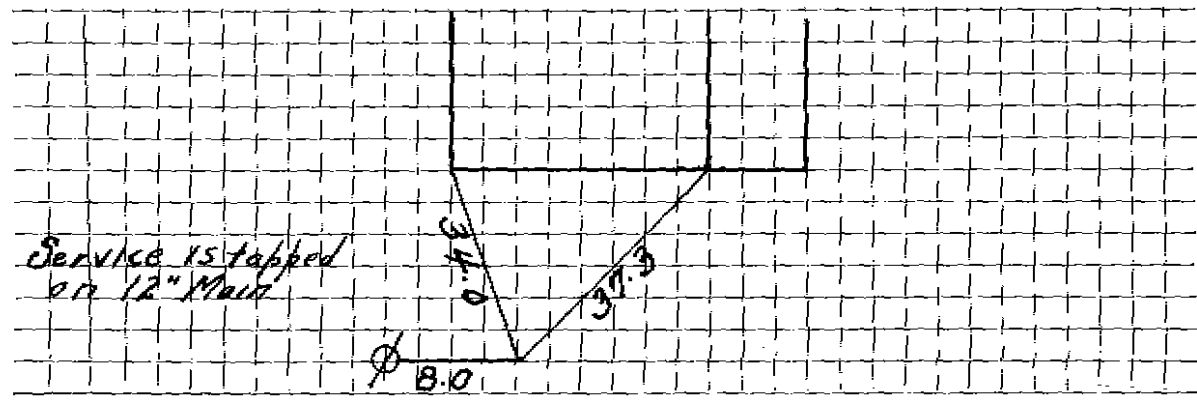

Connection made in _____ Street.

Work completed _____ 19

Remarks: