

Name C. Henry Jackson

#8744

Service No. 161

Address 40 Clarke Street

Lexington, Mass.

Location 40 Clarke Street

Kind of Pipe

Size

Size of Main

~~Repair~~ Renewal—~~New Service~~

Com. 12-31-49

Location

Date	Material	Amount	Total	Date	Amount
Jul. 6, '49	Labor	22 85	22 85	July 5, '49	90 00
	10% Overhead		2 29	Ret 31 '49	12 04
	63' - 2" C. L. Pipe @.45		28 35		72 96
	1 - 2" W. H. Gate Valve		6 40	July 6, '49	65 07
	2 - 2" L. L. Elbows		2 44	July 7, '49	5 65
	2 - 2" Brass Nipples 3 1/2" Long		2 88	5' - 2" C. L. Pipe @.45	2 25
	Littlefield Shovel 1 hr. @ 7.00	7 00	7 00	40' - 1" Copper T,bing @.30	12 00
	Trucking 1 hr. @.75		75	3 - 1" C Corp-cocks @ 4.62	13 86
			72 96	1 - 2" I x 1" C 4-way Branch	12 18
				1 - 2" I x 2" I Curb-cock O/L	11 17
				1 - Gate Box	3 95
				Littlefield Shovel 1 1/2 hrs. @7.00	10 50
	Labor			Trucking 1 hr. @.75	75
				Patching 12 x 3	12 00
					149 38

DATE _____

TOWN OF LEXINGTON - BOARD OF PUBLIC WORKS

WATER DIVISION

The undersigned applies for a supply of water at No..... St. and hereby agrees to comply with the rules and regulations as now, or at any future time, established by the Board of Selectmen.

Am't of Estimate \$.....

Owner


Am't Paid \$.....

Address

Builder

Sketch of Service Here

*curb o/l
sheet off R*

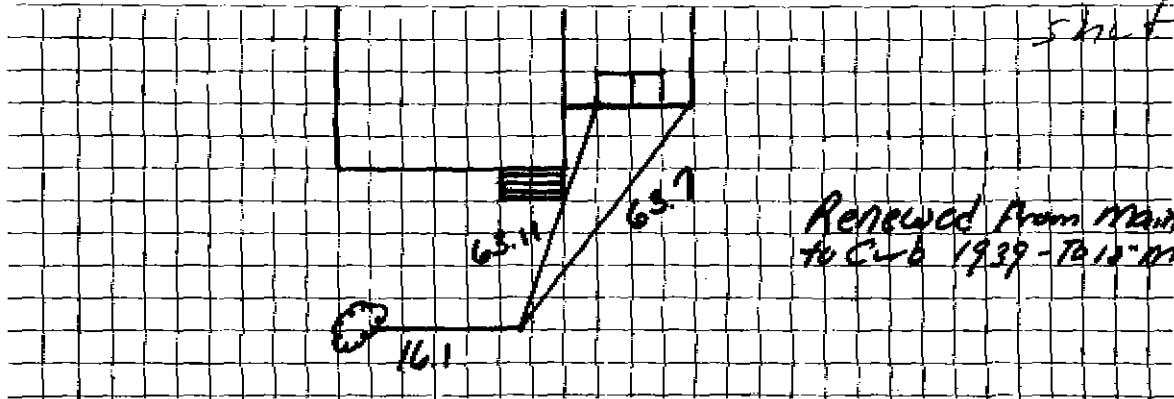

*Renewed from main
to curb 1939 - to 12" main*

Connection made in Street.

Work completed19

Remarks: