

Name Elizabeth Wourse

Service No. 213

Address 41 Clarke Street

Lexington, Mass.

Location 41 Clarke Street

Kind of Pipe

Size

Size of Main

~~Repair—Renewal—New Service~~

Com. 11-6-50

Location

Date

Material

Amount

Total

Date

Amount

AUG. 2, 50

Labor

27 65

27 65

*2114 1 00*

*12 Clarke St*

27 65

10% Overhead

2 77

*11%*

2 77

10' - 3/4" Copper Tubing @.23

9 23

No Charge

9 23

1 - 3/4" C x 1/2" I. V. H. Saw

3 29

AUG. 2, '50

Labor

10 00

Trucking 1 hr. @.75

75

1 - 1/2"

Straight Tail Piece

1 12

43 66

10 12

Labor

DATE \_\_\_\_\_

# TOWN OF LEXINGTON—BOARD OF PUBLIC WORKS

## WATER DIVISION

The undersigned applies for a supply of water at No. \_\_\_\_\_ St. and hereby agrees to comply with the rules and regulations as now, or at any future time, established by the Board of Selectmen.

Am't. of Estimate \$ \_\_\_\_\_


Owner \_\_\_\_\_

Am't. Paid \$ \_\_\_\_\_

Address \_\_\_\_\_

Builder \_\_\_\_\_

Sketch of Service Here

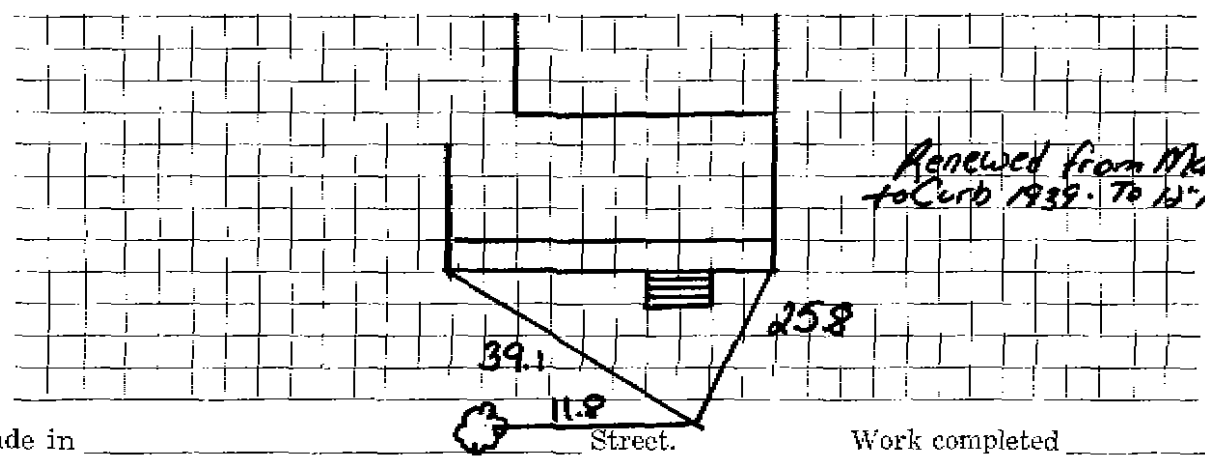

*Renewed from Main  
to Curb 1939. To 12" Main*

Connection made in \_\_\_\_\_

Work completed \_\_\_\_\_ 19

Remarks: