

WATER SERVICE RECORD

3525

Name

Service No.

Address 15 Clelland Road

Location

~~Repair~~—Renewal—~~NEW SERVICE~~ W.O. #3046


Date	Material	Amount	Total	Date	Amount
	<u>MAIN TO CURB</u>			10/2/1997	35'-1"Ø COPPER 1 CURB STOP
8-8-66	Labor 134.42				
8-10-66	Labor 25.60				
8-19-66	Patching <u>42.42</u>	202 44			
	10% O.H.	20 24	222 68		
29'	3/4" copper tubing @ .79		22 91		
1	1" repair clamp		2 25		
1	1 x 1/2 cement lined nipple		98		
1	1" lead lined coupling		2 81		
1	3/4" Curb cock		8 76		
1	3/4" Adaptor		2 76		
1/4	Yard Loam @ 3.00		75		
2 1/2	Ton hot top @ 5.50		12 75		
13	Hrs. Trucking @ 3.00		39 00		
3	Hrs. Tractor @ 6.50		19 50		
3	Hrs. Compressor @ 5.00		15 00		
			350 15		

DATE _____

TOWN OF LEXINGTON — BOARD OF PUBLIC WORKS

WATER DIVISION

Sketch of Service Here

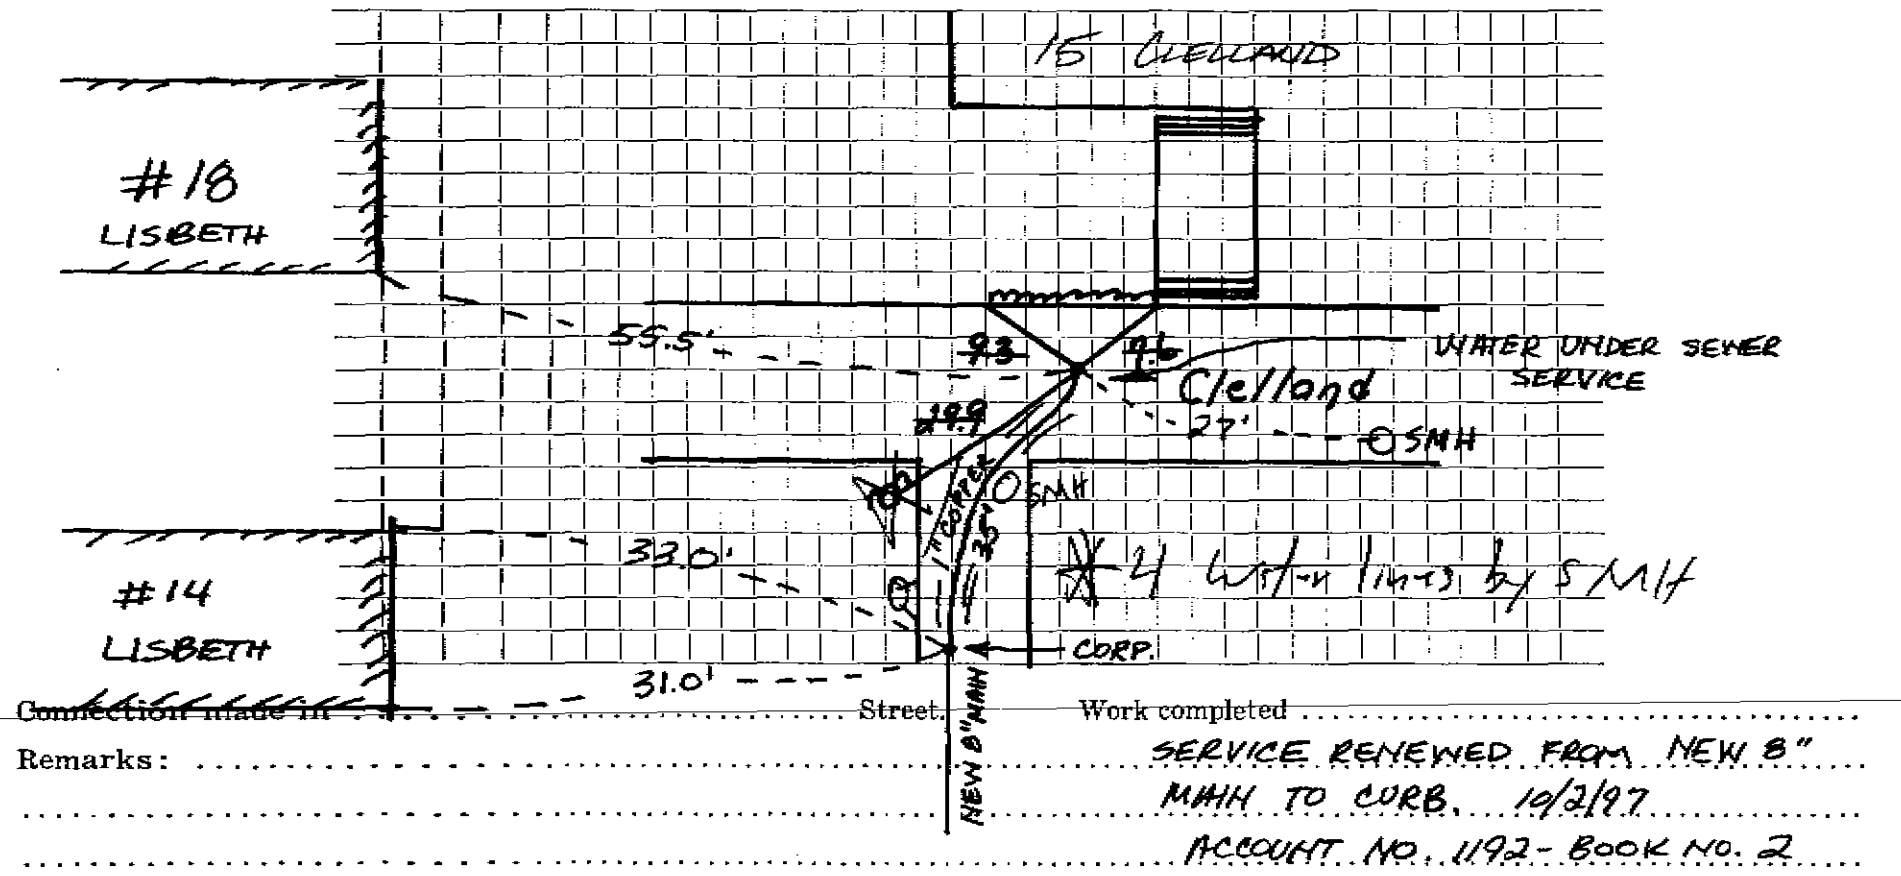

Connection made in _____ Street.

Work completed _____

Remarks: _____

SERVICE RENEWED FROM NEW 8"
 MAH TO CORB. 10/2/97
 ACCOUNT NO. 1192 - BOOK NO. 2