

WATER SERVICE RECORD

Name David P. Carpenter

Service No. 55

Address 17 Glelland Road

Location

~~Repair~~ ~~Renewal~~ ~~New Service~~ W.O. #8819

Comm 9-21-64


Date	Material	Amount	Total	Date	Amount
				6-5-64	Deposit 150.00
				9-21-64	Retund 50.77
					99.23
					<del>Curb to Main</del> <del>NON SERVICE</del>
				6-4-64	Labor 72.11
				1 3/4" C Adapter	1.62
				3 hrs. Town Shovel @6.50	19.50
				2 hrs. Trucking @3.00	6.00
					99.23
				12-14-64	Abated 99.23
					Billed in error

DATE \_\_\_\_\_

# TOWN OF LEXINGTON — BOARD OF PUBLIC WORKS

## WATER DIVISION

Sketch of Service Here

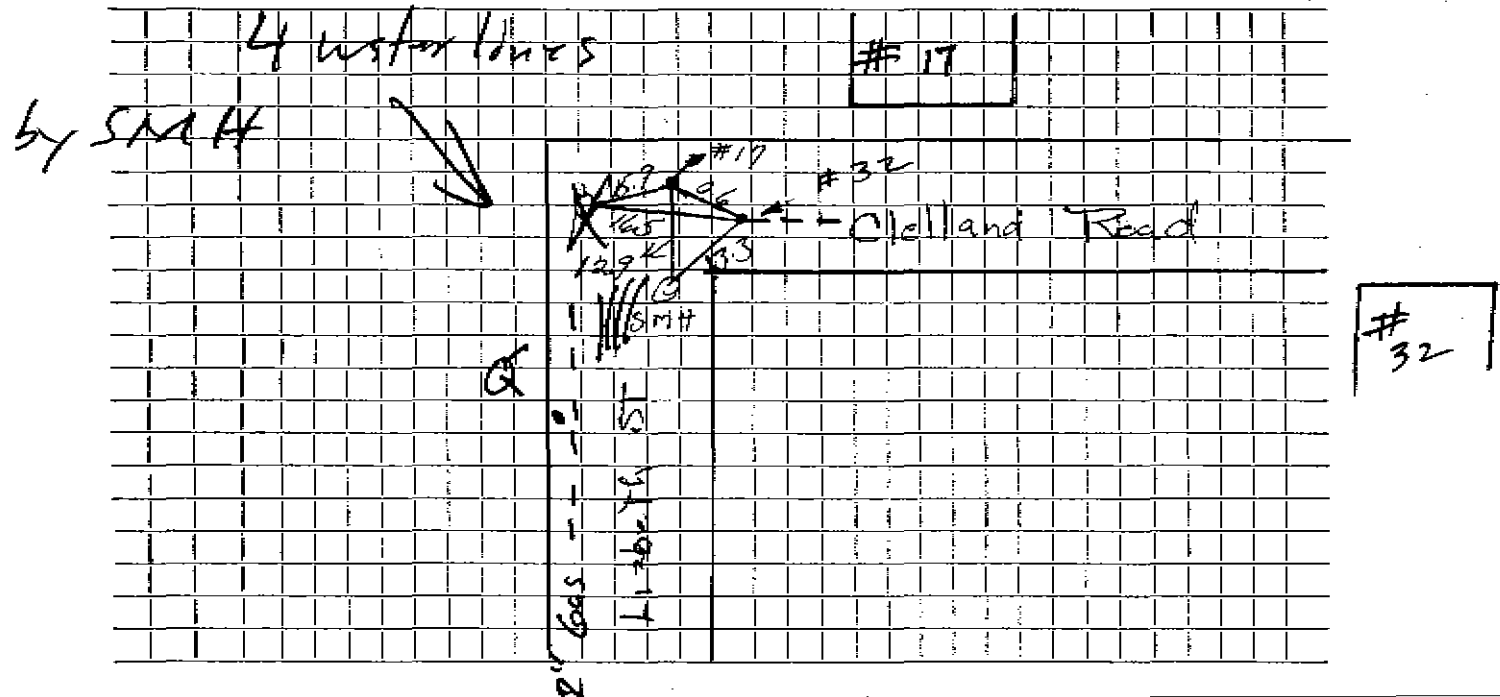

Connection made in ..... Street. Work completed .....

Remarks: .....

.....

.....