

WATER SERVICE RECORD

Name Mr. Lawrence Jordan

Service No. 2

Address 32 Clelland St.

#7800

Location

Repair ~~Renewal~~ ~~New Service~~

W.O. # 7375

JUL 27 1970

Date	Material	Amount	Total	Date	Amount
3/9/70	Labor	144 16		3-26-70	6.50 00
3/10/70	"	14 01		7-27-70	75 47
3/11/70	"	98 07	256 24		574.53
10%	O.H.		25 62		
149'	Copper pipe @ 1.01		150 49	3/16/70	112 08
2	1"-Unions @ 2.81		5 62	4/21/70	43 22
1	1"-Curb cock		14 43	22'	1"-Copper pipe 1.01
1	1"-Wheel Valve		12 53	1	1"-corporation
	Box & Rod		5 10	1	1"-curb box cock
5	Hrs. trucking @ 3.00		15 00	1	Box & rod
13	" shovel @ 6.50		84.50	1/4	Ton cold Patch 5.85
1	" compressor		5 00	3 1/2	Hrs. trucking 3.00
			574 53	1	Hr. trucking
				5 1/2	Hrs. shovel @ 4.00
				1	Hr. compressor
				1	" roller
					Trailer
					2 00
					252 17

Deposit
Retard

OUTSIDE


DATE _____

TOWN OF LEXINGTON -- BOARD OF PUBLIC WORKS

WATER DIVISION

4 water lines 2" by sewer man hole

Sketch of Service Here

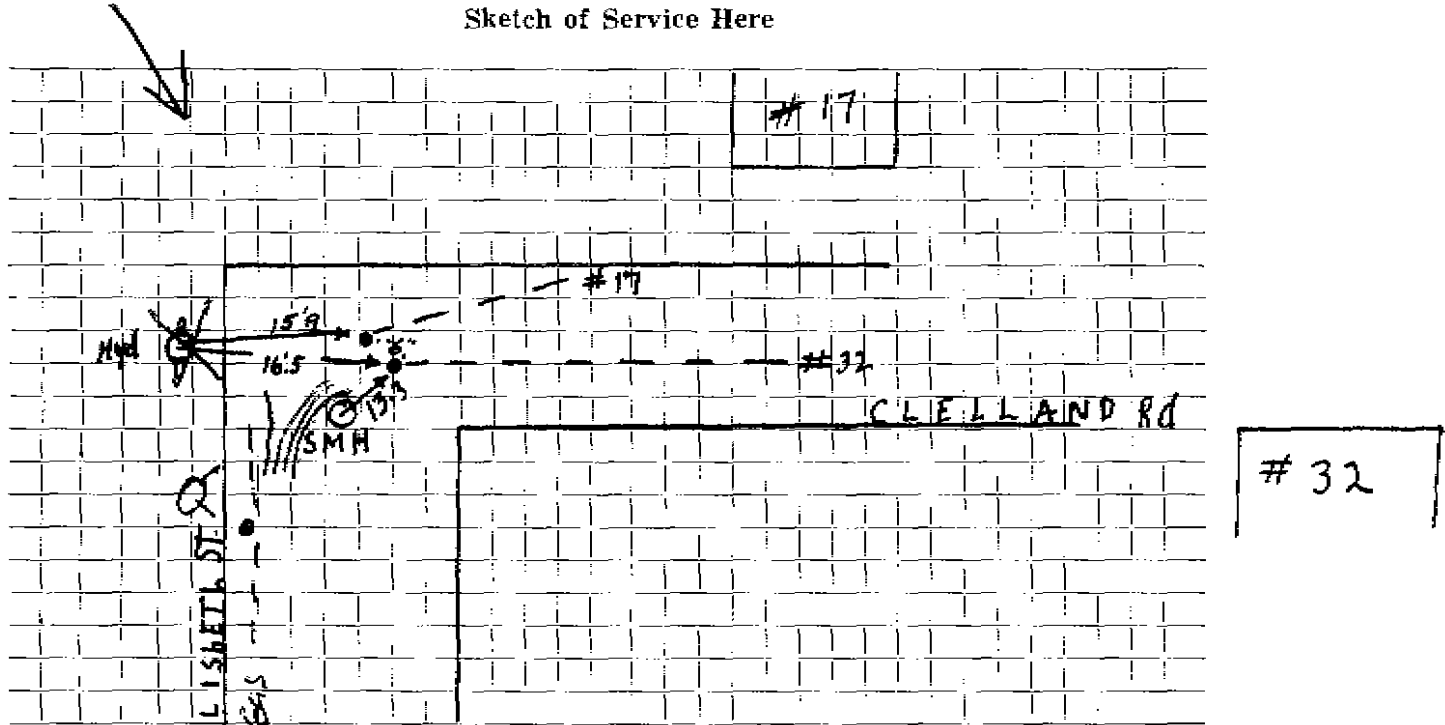

Connection made in Street. Work completed

Remarks:

.....

.....