




DATE \_\_\_\_\_

TOWN OF LEXINGTON — BOARD OF PUBLIC WORKS  
**WATER DIVISION**

Sketch of Service Here

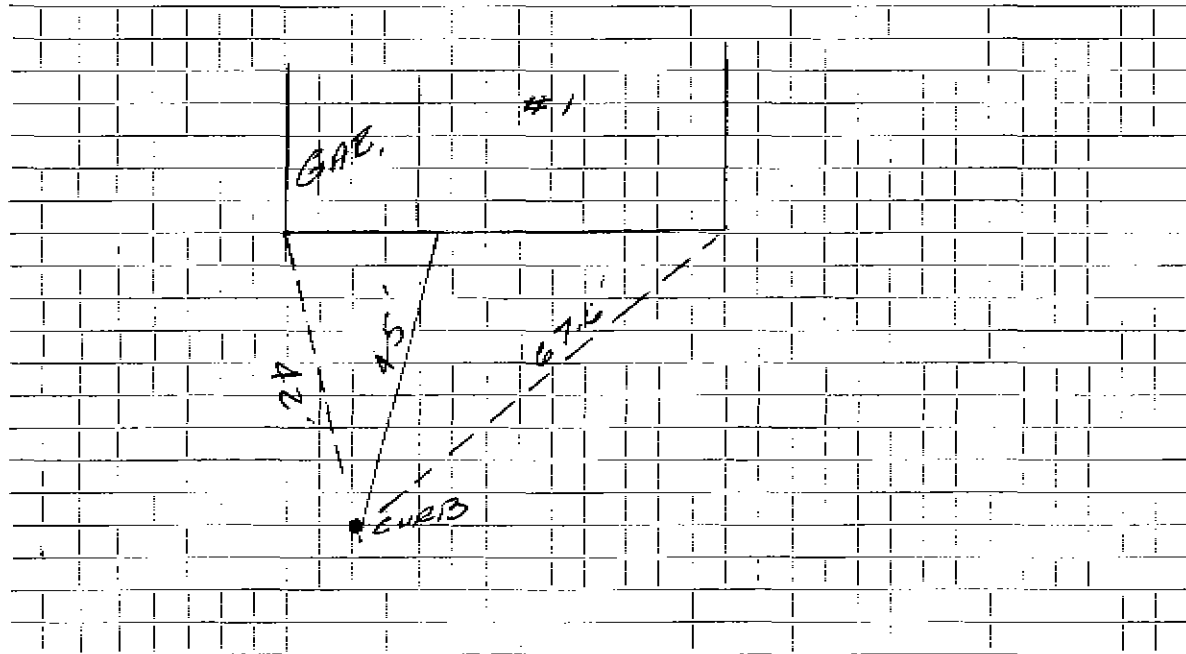

Connection made in CLEMATIS Street. Work completed .....

Remarks: NO OUTSIDE WATER TIES .....

Sub division .....