


DATE _____

TOWN OF LEXINGTON — BOARD OF PUBLIC WORKS
WATER DIVISION

Sketch of Service Here

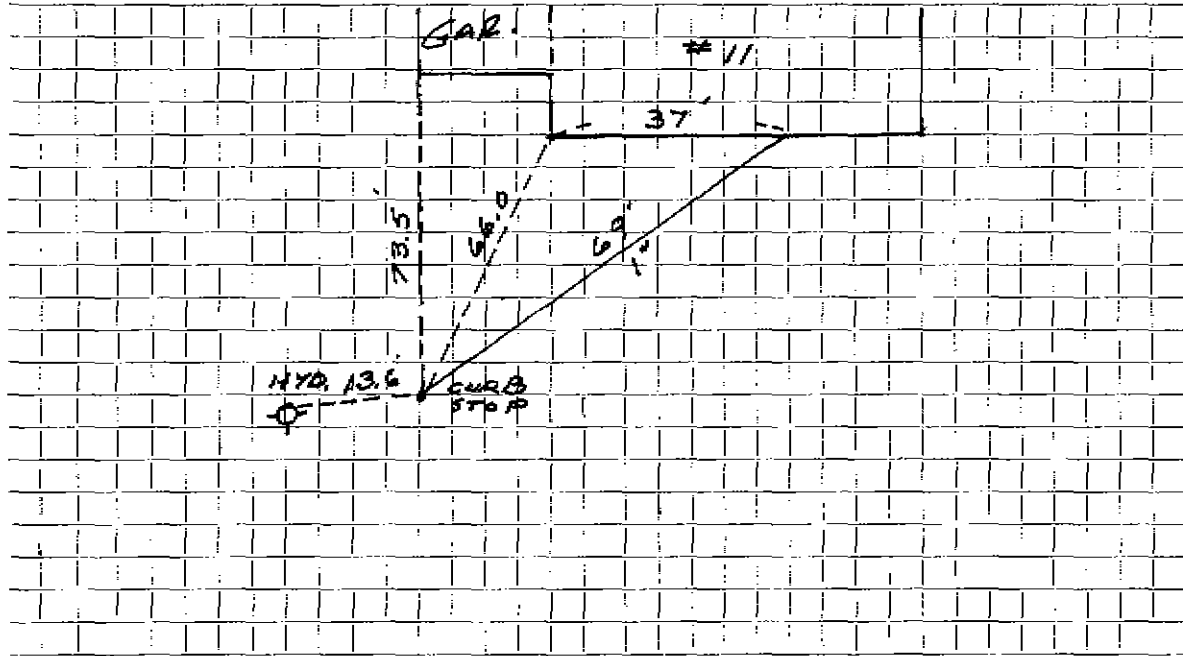

Connection made in CLEMATIS Street. Work completed

Remarks: NO. OUTSIDE TIES - Subdivision