

WATER SERVICE RECORD

Name Evangelical Covenant Church

Service No. 134 NP

Address ~~1111 Street~~ ~~1111~~ ~~1111~~ #30/70

Location 7 CLEMATIS RD 8/25/90

Repair—Renewal—New Service DeFelice Brothers - Permit #277 - W.O.#294

MAR 14 1956


Date	Material	Amount	Total	Date	Amount
5-4-65	CURB TO MAIN Labor	44 01		4-15-66	Deposit
	10 % O.H.	4 40	48 41		211 35
	26' 2" Copper tubing @ 1.30		33 80		
	1 2" Corp		26 36		
	1 2" Curb		42 88		
	1 Curb Box		13 40		
	1 Load Sand		15 00		
	1 Load Stone @ 1.25 (12 ton)		15 00		
	1 Hr. Town Shovel		6 50		
	1 Hr. Bozer		4 00		
	6 Hrs. Pump @ 1.00		6 00		
			211 35		
4-5-65	2" copper tubing				Bill sent 211.35

DATE _____

TOWN OF LEXINGTON — BOARD OF PUBLIC WORKS

WATER DIVISION

Sketch of Service Here

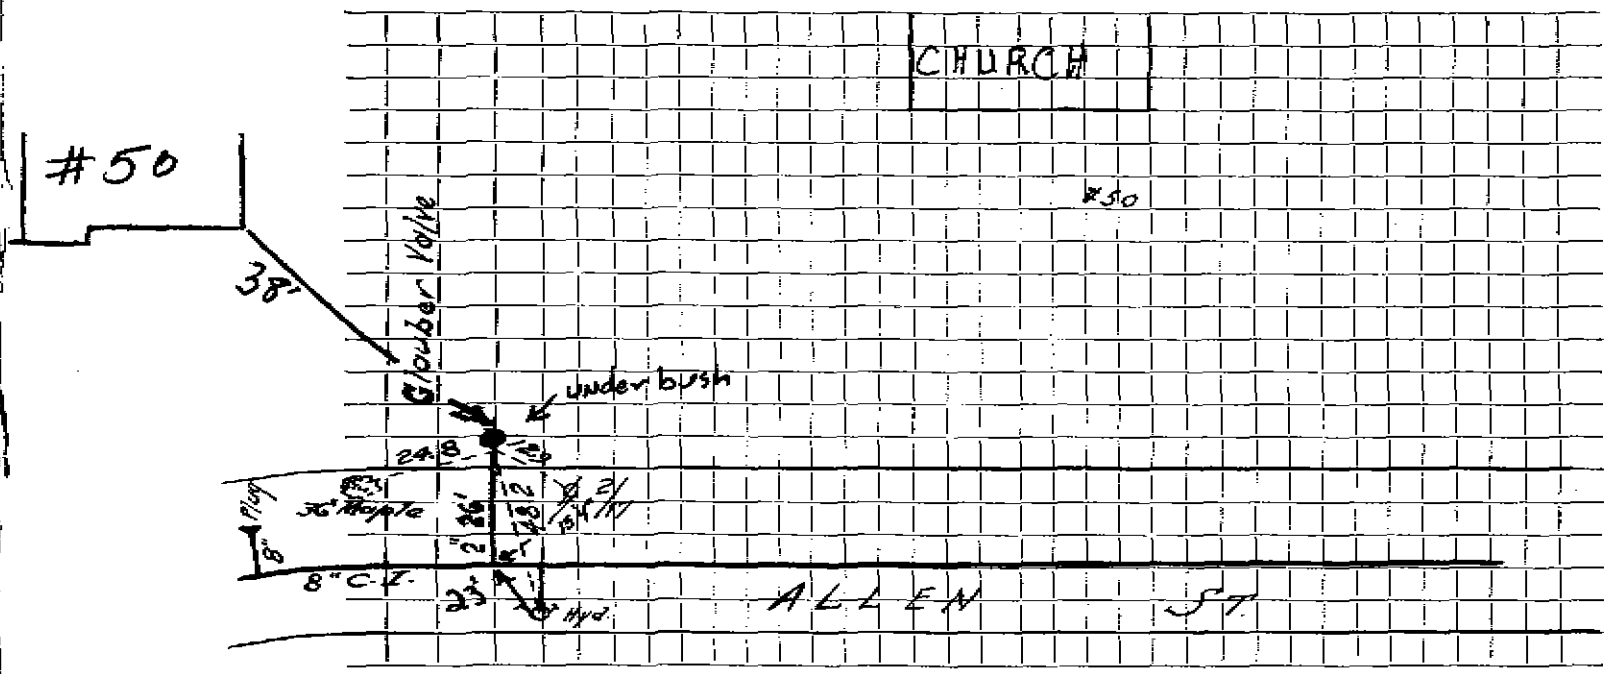

Connection made in Street. Work completed

Remarks: *Compd UNION 6' from Corp. 4-14-83*


DATE _____

TOWN OF LEXINGTON — BOARD OF PUBLIC WORKS

WATER DIVISION

Sketch of Service Here

LOT #3

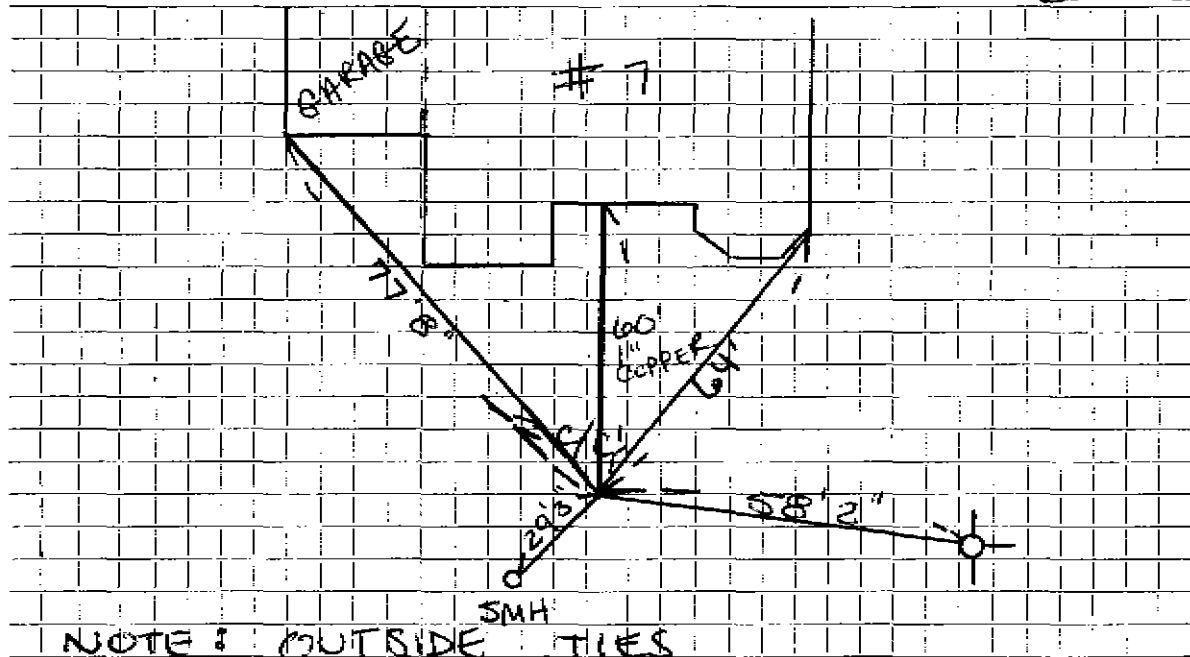

Connection made in ... CLEMATIS RD ... Street. Work completed

Remarks:

.....

.....