

WATER SERVICE RECORD

Name Joseph Dattoli

Dep't 100 for Serv # Dep't 71 July 17-1951  
Service No. 61

Address 101 Cliffe Avenue

# 790

Location Lexington, Mass.

Repair—Renewal—New Service

Com 10-1-51

Date	Material	Amount	Total	Date	Material	Amount
8-30-51	Labor	1 49	1 49	7-14-51	Deposited	50 00
	10% Overhead		15	10-9-51	Paid	50 56
	135'-3/4" Copper Tubing @.326	44 01				50 56
	1-3/4" Cx 1/2" L.W.H. S&W	4 00			No Charge	
	3-3/4" Cx 3/4" C Union (3 pts)	5 78		8-30-51	Labor	1 49
	1 Hr. Trucking		75		15'-3/4" Copper Tubing @.326	4 89
			55 58		1-3/4" C Corp-Cock	4 83
					1-3/4" Cx 3/4" C Curb-Cock	4 67
					1-Box & Rod	4 68
					1-1/2 Straight Tail Piece	50
					1-1/2 Offset Tail Piece	50
					1 Hr. Trucking	75
						21 81

DATE \_\_\_\_\_

# TOWN OF LEXINGTON—BOARD OF PUBLIC WORKS

## WATER DIVISION

The undersigned applies for a supply of water at No. \_\_\_\_\_ St. and hereby agrees to comply with the rules and regulations as now, or at any future time, established by the Board of Selectmen.

Am't. of Estimate \$ \_\_\_\_\_

Owner

ambrose montath


Am't. Paid \$ \_\_\_\_\_

Address

cliff ave.

Builder \_\_\_\_\_

Sketch of Service Here

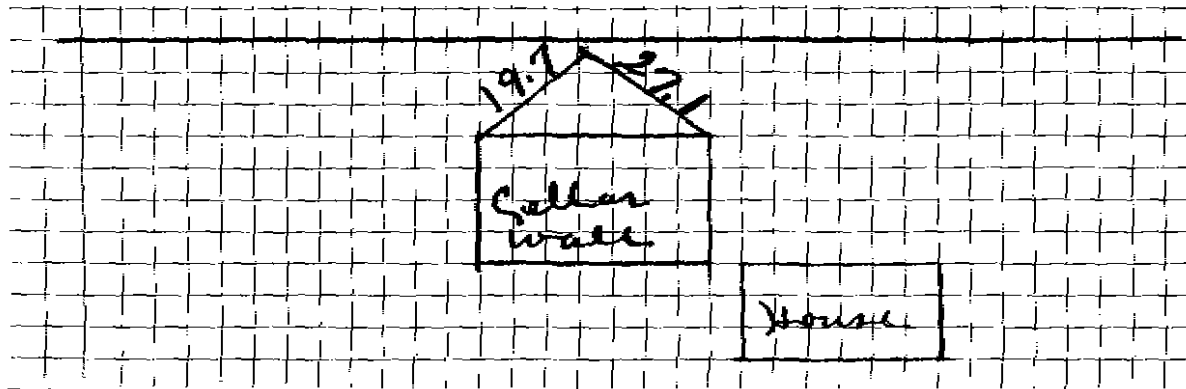

Connection made in \_\_\_\_\_ Street. Work completed \_\_\_\_\_ 19

Remarks:

Name

Service No. 601

Address

Location

Kind of Pipe

Size

Size of Main

Repair—Renewal—New Service

Location

Date

Material

Amount

Total

Date

Amount

Labor

Name

*Roberts*

Service No.

600

Address

Location

Kind of Pipe

Size

Size of Main

Repair—Renewal—New Service

Location

Date

Material

Amount

Total

Date


Amount

Labor

DATE \_\_\_\_\_

**TOWN OF LEXINGTON — BOARD OF PUBLIC WORKS**  
**WATER DIVISION**

Sketch of Service Here

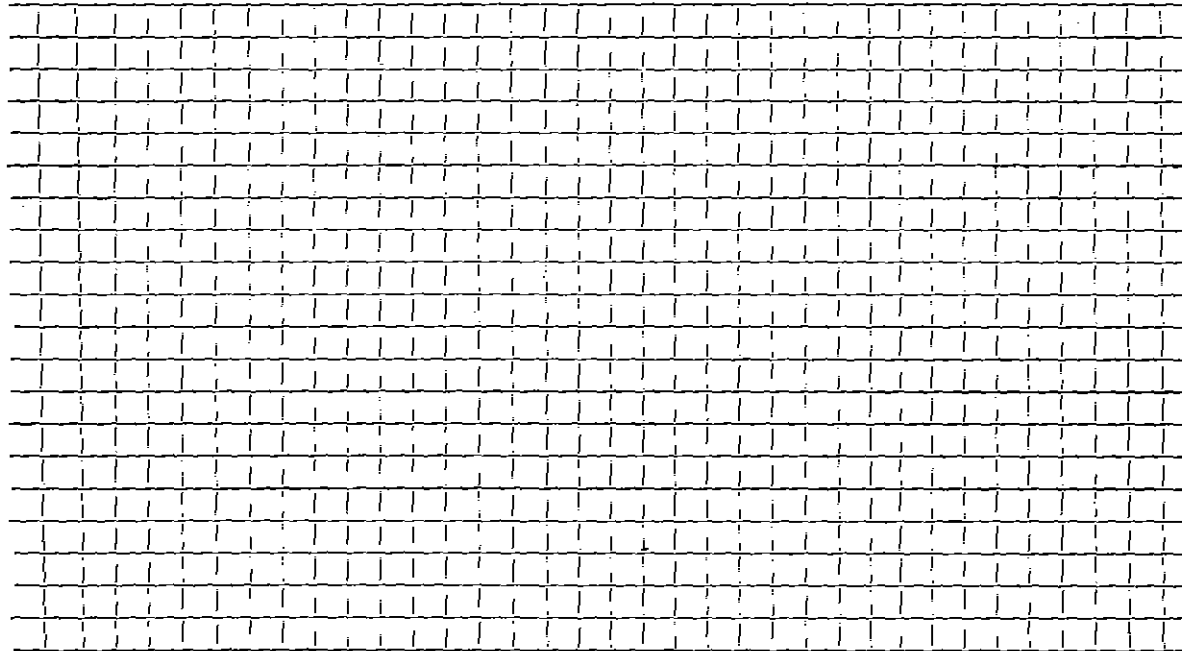

Connection made in ..... Street.                      Work completed .....

Remarks: .....

.....

.....