

Name Harry H. Chute

Service No. ~~5~~ 579

Address 12 Cliffe Avenue, Lexington, Mass.

6482

Location Service formerly came from Oxford St.,

Kind of Pipe

Size

Size of Main

~~Repair~~ ~~Renewal~~ New Service

Location

Date 1939	Material	Amount	Total	Date	Amount
May 2	16 hrs. @ 55¢	8 80		April 29 1939	40 00
<i>Tom 5/10/39</i>	18 " 60¢	10 80		May 15 1939	2 86
	2 " @ 65¢	1 30	20 90	Refunded	<u>37 14</u>
	10% Overhead		2 09		
	35' 3/4" Copper Tubing @ 20¢		7 00		
	1 3/4" S. & W.		3 75		
	1 3/4" Union		1 00		
	1 1" Close Nipple		90		
	Trucking- 2 hrs. @ 75¢		1 50		
			37 14		
	Labor				

Hanley Press, Inc., Lexington

DATE April 27, 1939

TOWN OF LEXINGTON—BOARD OF PUBLIC WORKS

WATER DIVISION

The undersigned applies for a supply of water at No. 12 Cliffe Ave. St. and hereby agrees to comply with the rules and regulations as now, or at any future time, established by the Board of Selectmen.

Am't. of Estimate \$ 44.⁰⁰ Town digging
18.⁰⁰ owner dig.


Owner Harry H. Bute

Am't. Paid \$ _____

Address 12 Cliffe Ave
Lex

Builder _____ exclusion of ledge

Sketch of Service Here

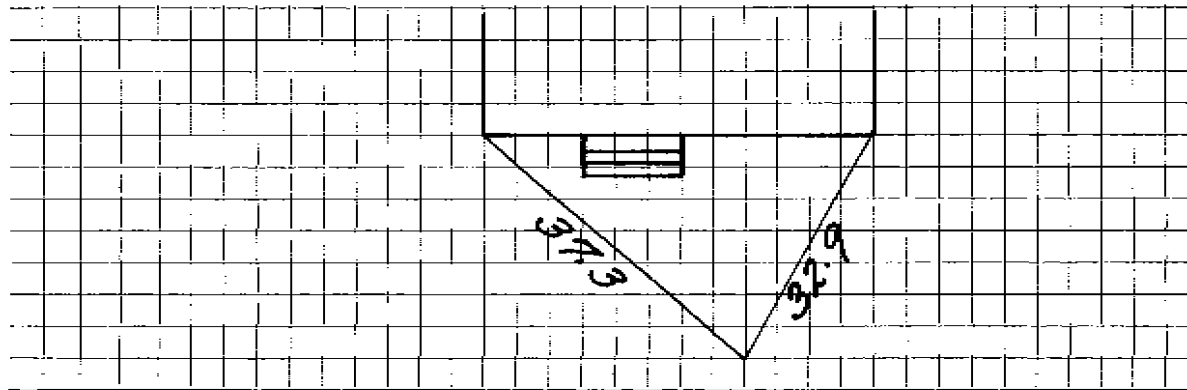

Connection made in _____ Street.

Work completed _____ 19

Remarks: