

WATER SERVICE RECORD

4752

Name Richard E. Manley

Service No. 19

Address 14 Cliffe Avenue

Location

~~Repair~~—Renewal—~~NEW SERVICE~~ W.O. # 6384

JUL 7 1969


Date	Material	Amount	Total	Date	Amount
5/28/69	Labor	83 68		5-28-69	Deposit
	10% O.H.	8 37	92 05	7-7-69	Refund
26'	3/4" Copperpipe .79		20 54		
1	3/4" Wheel Valve		9 30		
2	Yds. Loam 3.50		7 00	4/14/66	
2	Lbs. Grass seed 1.10		2 20	22'	3/4 COPPER
2	Hrs. trucking 3.00		6 00	1	3/4 Curb
3	" shovel 6.50		19 50	1	3/4 CORP ADAPTER
			156 59		
				7/25/68	1 12x6 tapped 3/4 resp sand
					1 3/4" corp
					3 3/4" copper
					1 3/4 thru part union

DATE _____

TOWN OF LEXINGTON -- BOARD OF PUBLIC WORKS

WATER DIVISION

Sketch of Service Here

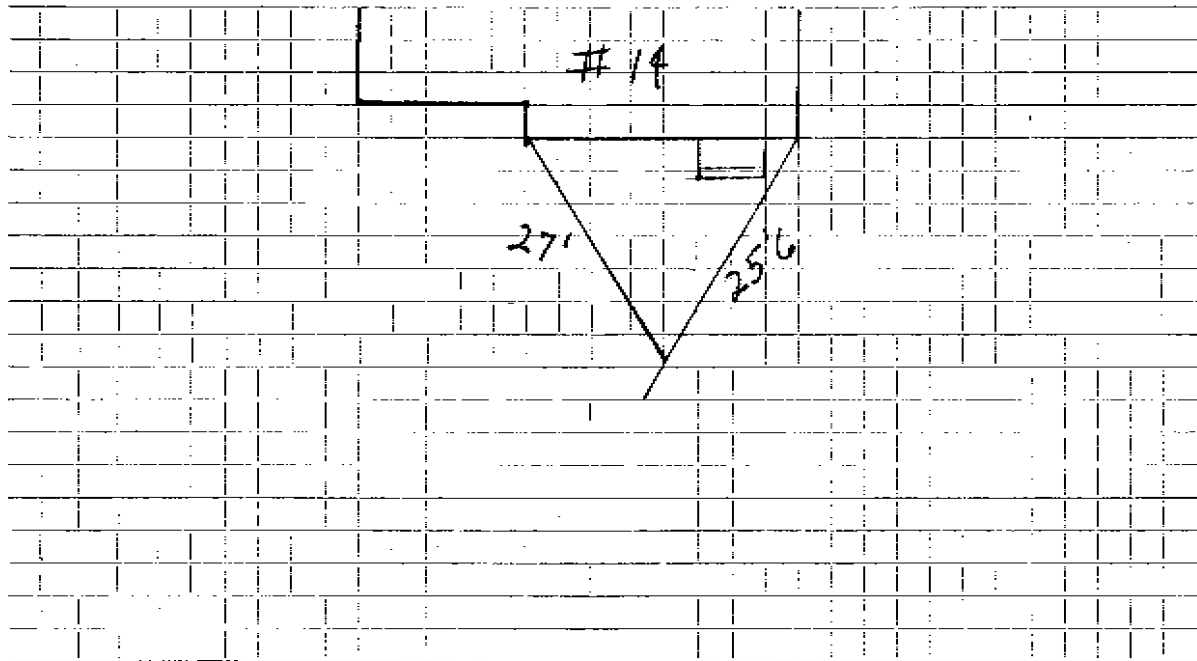

Connection made in Street. Work completed

Remarks: Service broken at main and repaired with 12" dia. repaired top and with 3" o.p. 24" pipe.
 3" pot. union under gas main (gas and water service in same trench in street.)
 water main 2' from gas main