

WATER SERVICE RECORD

Name

Service No.

Address # 32 Cliffe Avenue

6864

Location

~~Repair~~—Renewal—~~New Service~~ W.O. # 9422


Date	Material	Amount	Total	Date	Amount
9/23/30	26' 1" CLP				
	1 S&W				
					OUTSIDE
				4/6/71	Labor 132 55
4-13/99	1 1" 3pc union			4/23/71	" 101 63
	3' 3/4" copper			32'	3/4" Copper pipe .79 25 28
	23' 1" copper			1	3/4" Gurb cock 11 32
				1	1" Repair clamp 5 05
				1	1" x4" Nipple 60
				1	1" Coupling 83
				1/2	Ton cold patch 8.00 4 00
				11	Ton hot top 7.45 81 95
				7	Hrs. Trucking 3.00 21 00
				3	" Shovel 4.00 12 00
				3	" Compressor 3.00 9 00
				XI 1/2	" Trucking 1.50 75
				1	" Roller 2 00
					Trailer 2 00
					409 96

DATE _____

TOWN OF LEXINGTON — BOARD OF PUBLIC WORKS

WATER DIVISION

Sketch of Service Here

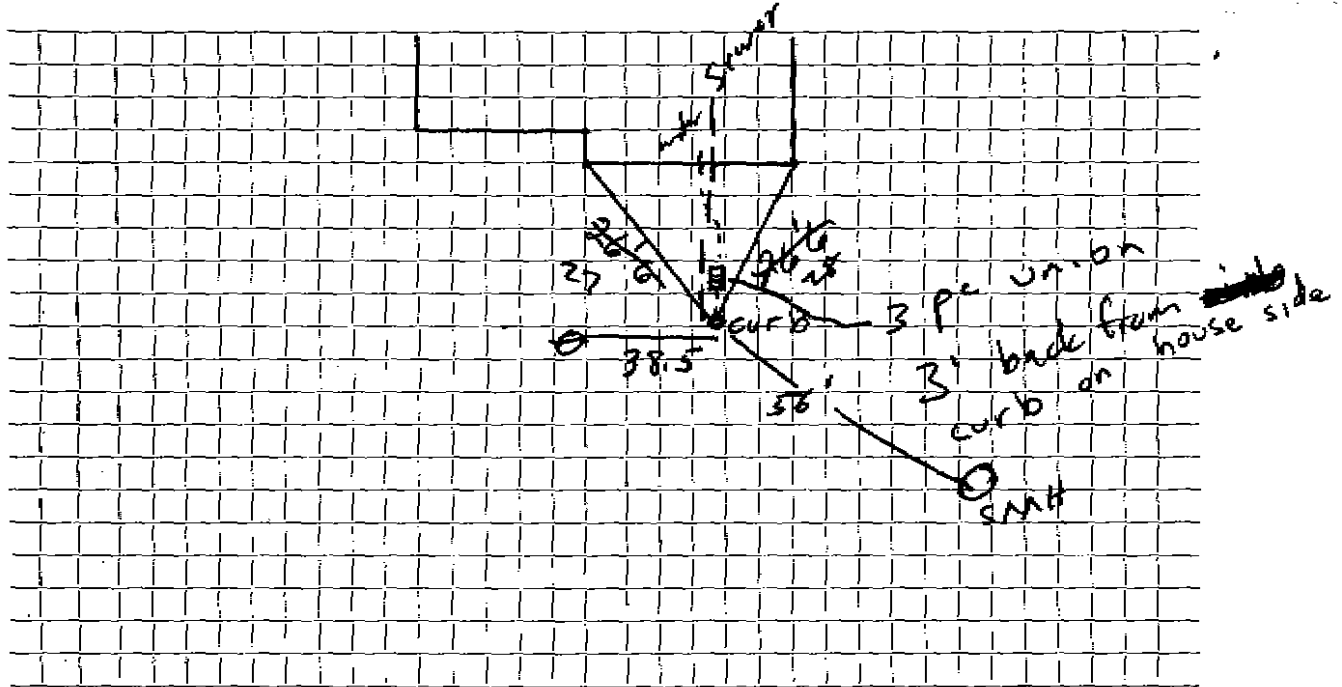

Connection made in Street. Work completed

Remarks: .. Water cross sewer .. Water 4'-3" deep sewer 4'-6" deep