

WATER SERVICE RECORD

Name Robert Burns

Service No. 48

Address 37 Cliffe Avenue

Location

~~XX Repair - Renewal - New Service~~

Comm 4-16-61


Date	Material	Amount	Total	Date	Amount	
4-28-61	Labor	33.77		4-24-61	Dupes. T	100.00
	10% D.P.	3.38	37.15	4-16-61	ReSand	28.72
	28' 3/4" Copper Tubing @ .42		11.76			21.68
	1 3/4" Cx& IWH Stop & Waste		6.17		NOV CHARGE	
	2 Hrscippin Shovel @ 5.00		10.00	4-28-61	Labor	12.06
	2 Hrs. Trucking @ 3.00		6.00		10' 3/4" Copper Tubing @ .42	4.20
			71.08		1 3/4" C Curb Cock	6.28
					1 3/4" Adapter	2.21
					1 1/2 Straight tailpiece	.50
					1 Hr. cippin Shovel @ 5.00	5.00
					1 1/2 offset tailpiece	.50
						30.75
					8 x 3 Patch	8.00
						38.75

DATE _____

TOWN OF LEXINGTON — BOARD OF PUBLIC WORKS

WATER DIVISION

Sketch of Service Here

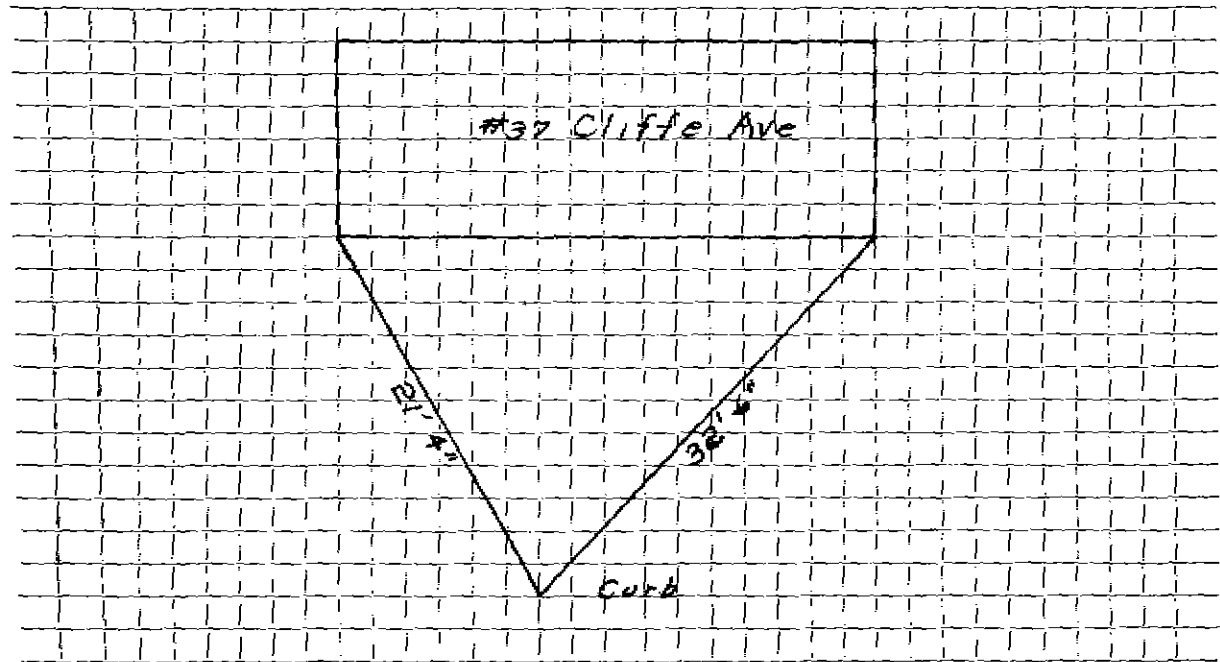

Connection made in Street. Work completed

Remarks:
.....
.....