




DATE 4-10-97

TOWN OF LEXINGTON — BOARD OF PUBLIC WORKS

WATER DIVISION

Sketch of Service Here

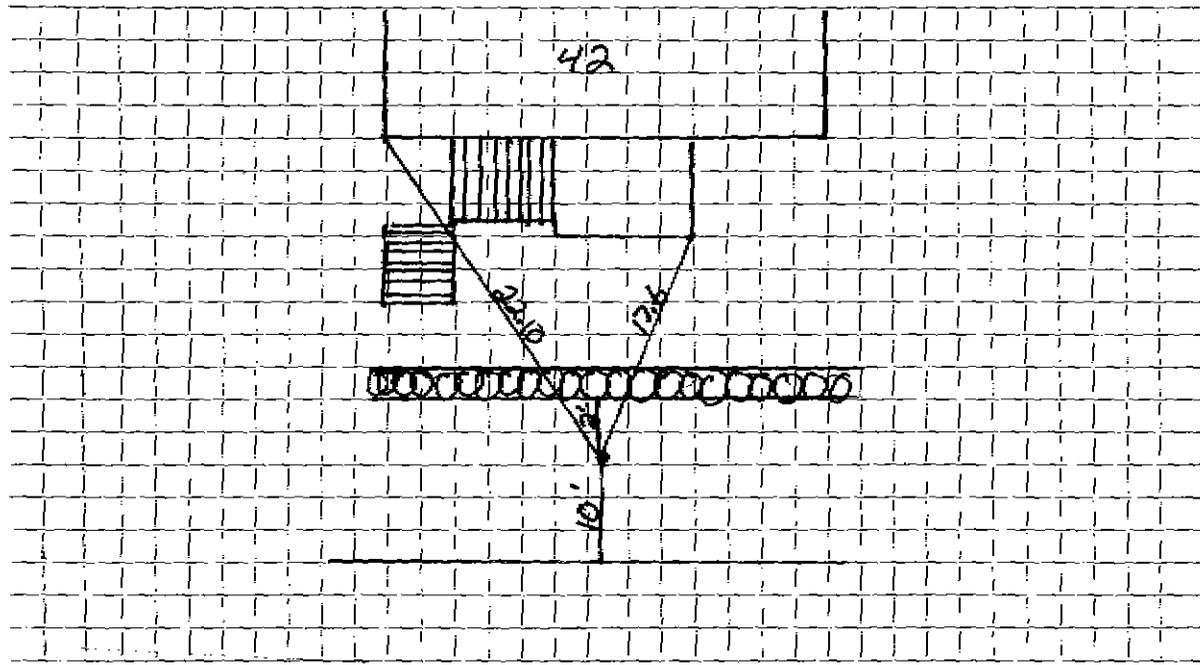

Connection made in ..... Street. Work completed 4-10-97 .....

Remarks: 4'-0" OF Copper under wall... S.T.Y.L.C. 88... USED 2' inside wall .....