

WATER SERVICE RECORD

#4990

Name Richard O'MaroService No. 141Address 67 Cliffe Avenue


Location

~~Repair Service~~ New Service W.O. #7643Comm 12-10-62

Date	Material	Amount	Total	Date		Amount
10-9-62	Labor	26.60		10-1-62	Deposit	100.00
	10% O.H.	2.66	29.26	12-10-62	Refund	32.97
30'	3/4" Copper tubing @.42		12.60			67.63
1	3/4" CX 1/2 I.W.H. Stop & Waste		6.17			
2	Hrs. Town Shovel @6.50		13.00		NON CHARGE	
2	Hrs. Trucking @3.00		6.00	10-9-62	Labor	12.42
			67.03	14'	3/4" Copper tubing @.42	5.88
				1	3/4" C Corp Cock	4.91
				1	3/4" C Curb Cock	6.28
				1	Box & Rod	4.90
				1	Hr. Town Shovel @6.50	6.50
				1	Hr. Trucking @3.00	3.00
				1	1/2 Straight Tailpiece	.50
				1	1/2 Offset Tailpiece	.50
						44.89

WATER DIVISION

Sketch of Service Here

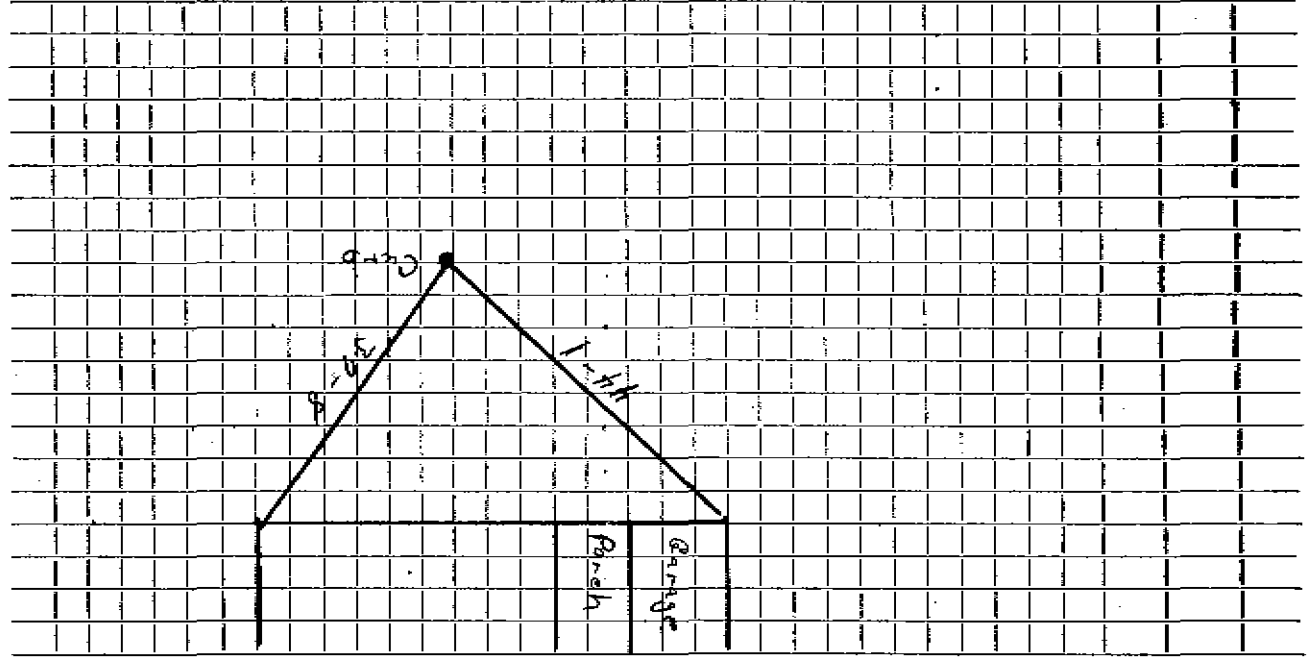

Connection made in _____

Street _____

Work completed _____

Remarks: _____

