

WATER SERVICE RECORD

Name Robert Hamblen

Service No. 203

Address 68 Cliffe Av.

Location

~~Main~~ - Renewal - ~~Main~~ Service

Com. 8-31-53


Date	Material	Amount	Total	Date	Amount
7/24/53	Labor	3 36		7-22-53	Deposited 25 -
	10% overhead	34	3 70	8-24-53	Refunded 15 66
	30' - 3/4" copper tubing @.3629	10 89			NON CHARGE 19 21
	1 - 3/4" C x 1/2" I.W.F. stop & waste	4 00			TRENCH DUG BY OWNER:
	1 hr. trucking		75		20' - 3/4" copper tubing @.3629 7 26
			19 34		1 - 3/4" C x 3/4" C. curb-cock 4 67
					1 - 3/4" C x 3/4" C. union 1 72
					1 box and rod 3 90
					1 - 1/2" straight tail pc. 50
					1 - 1/2" offset tail pc. 50
					1 hr. trucking 75
					19 30

DATE _____

TOWN OF LEXINGTON — BOARD OF PUBLIC WORKS

WATER DIVISION

Sketch of Service Here

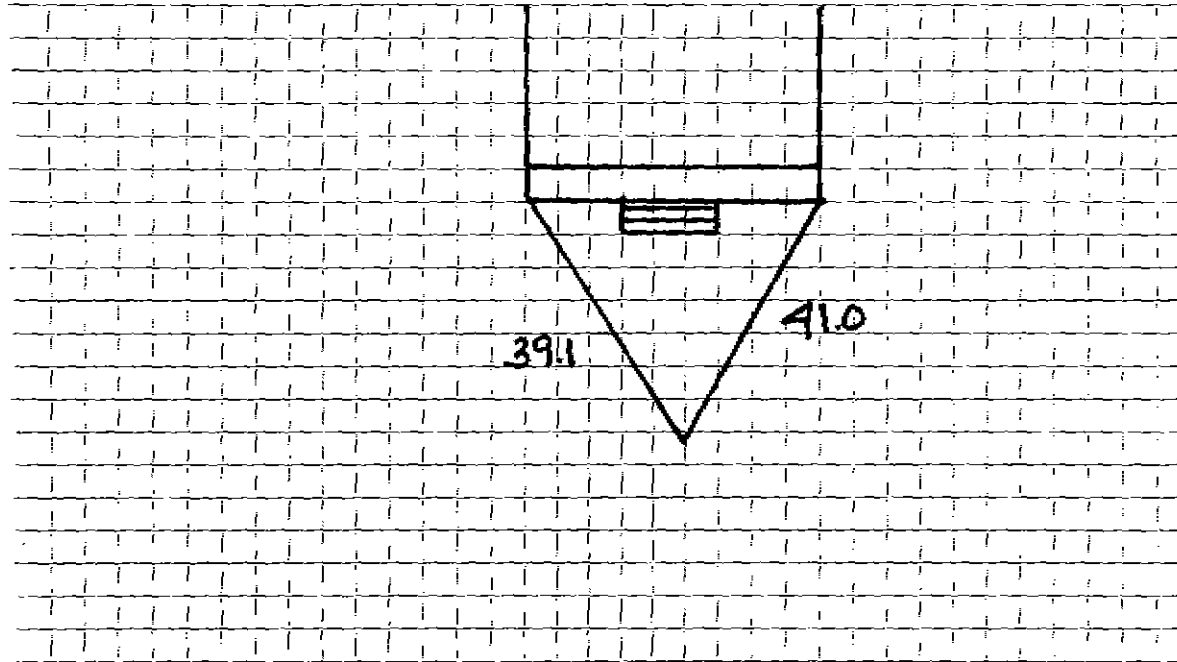

Connection made in Street: Work completed

Remarks:
.....
.....