

WATER SERVICE RECORD

# 4369

Name Donald Green

Service No. 45

Address 70 Cliffe Avenue

Location

Repair—Renewal—New Service W.O.#9051 *Valve # 1048*

DEC 31 1970

Date	Material	Amount	Total	Date	Amount
10-22-70	Labor	14.04		10-6-70	300.00
	10% O.H.	1.40	15.44	1-18-71	232.66
29'	3/4" Copper tubing @.79		22.91		47.34
1	3/4" Corp Cock		9.57		
1	3/4" Curb Cock		11.32		
1	Box & Rod		5.10		
1	hr. Trucking		3.00		
			67.34		
10-23-70	37' 3/4" Copper tubing				

*Deposit*

*\* Refund*


*\* Apply 46.97 to S.H.C.# 98*

DATE \_\_\_\_\_

TOWN OF LEXINGTON -- BOARD OF PUBLIC WORKS

**WATER DIVISION**

Sketch of Service Here

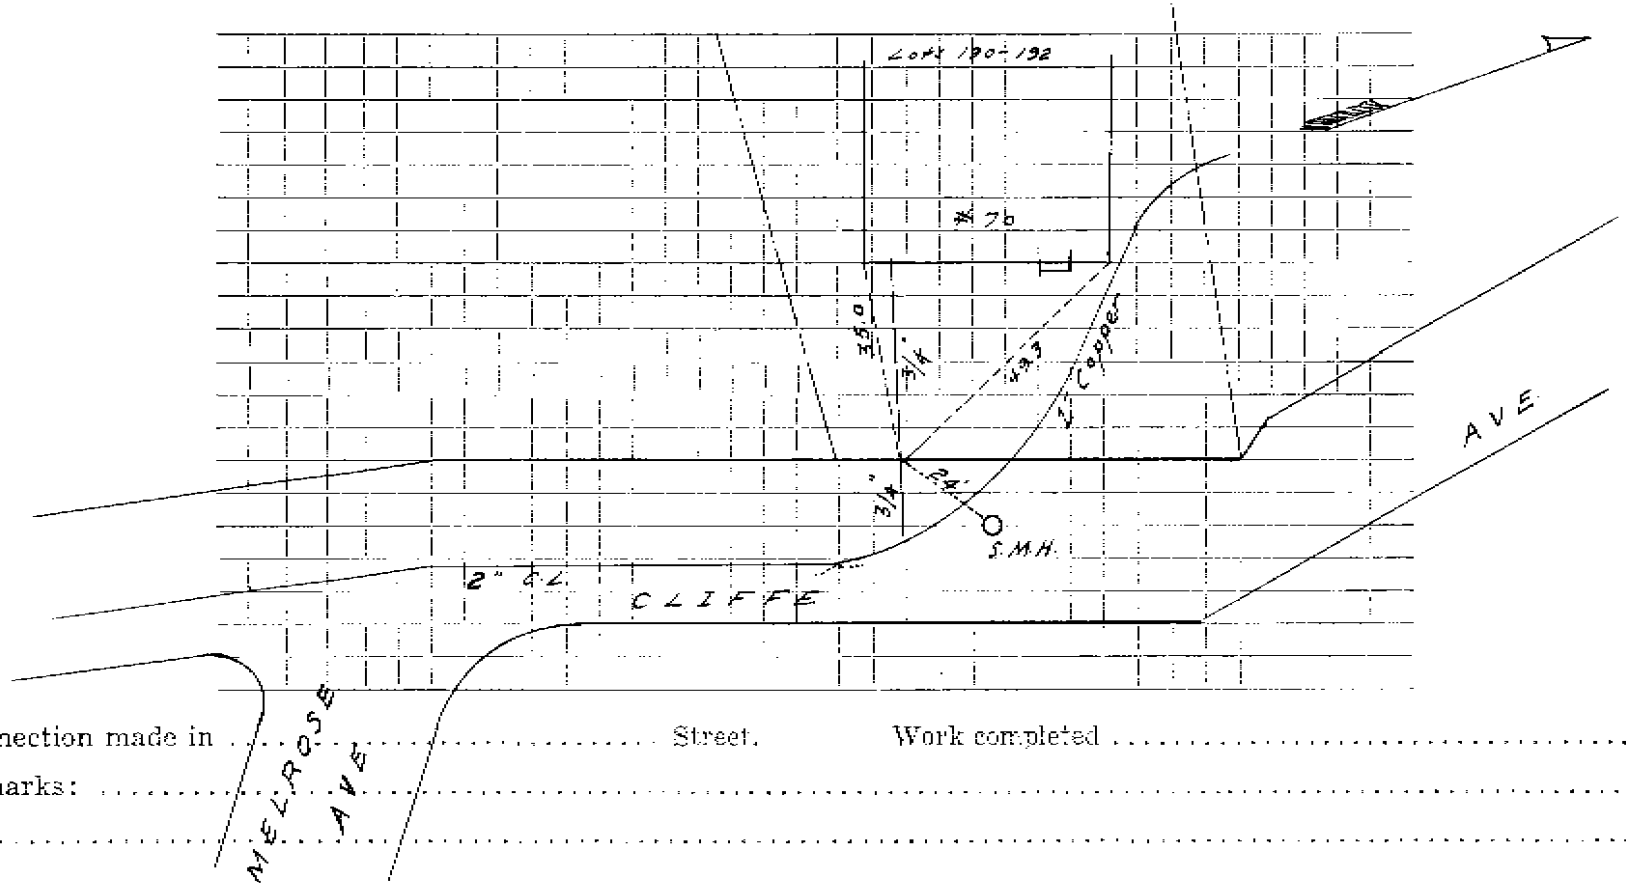

Connection made in \_\_\_\_\_ Street. Work completed \_\_\_\_\_

Remarks: \_\_\_\_\_

\_\_\_\_\_

\_\_\_\_\_