

WATER SERVICE RECORD

Name Leroy Johnston

Service No. 204

Address 78 Cliffe Avenue

Location

~~Repair - Renewal - New Service~~

Com. F-31-53

Date	Material	Amount	Total	Date	Amount
7/24/53	Labor	4 86		7-22-53	150 00
	10% overhead	49	5 35	7-22-53	68 31
	165' - 1" copper tubing @ .3997		65 95		21 65
	1 - 1" C x 1" I.W.H. stop & waste		5 12		
	2 - 1"C x 1"C. unions @ 2.26		4 52		
	1 hr. trucking		75		
			81 69		
				TRENCH DUG BY OWNER	
				15' - 1" copper tubing @ .3997	6 00
				1 - 1"C x 1"C. curb-cock	6 80
				1 - 1"C x 1"C. union	2 26
				1 box and rod	3 90
				1 - 3/4" Straight tail pc.	50
				1 - 3/4" offset tail pc.	50
				1 hr. trucking	75
					20 71


Deposited
Refunded
NON CHARGE

DATE _____

TOWN OF LEXINGTON — BOARD OF PUBLIC WORKS

WATER DIVISION

Sketch of Service Here

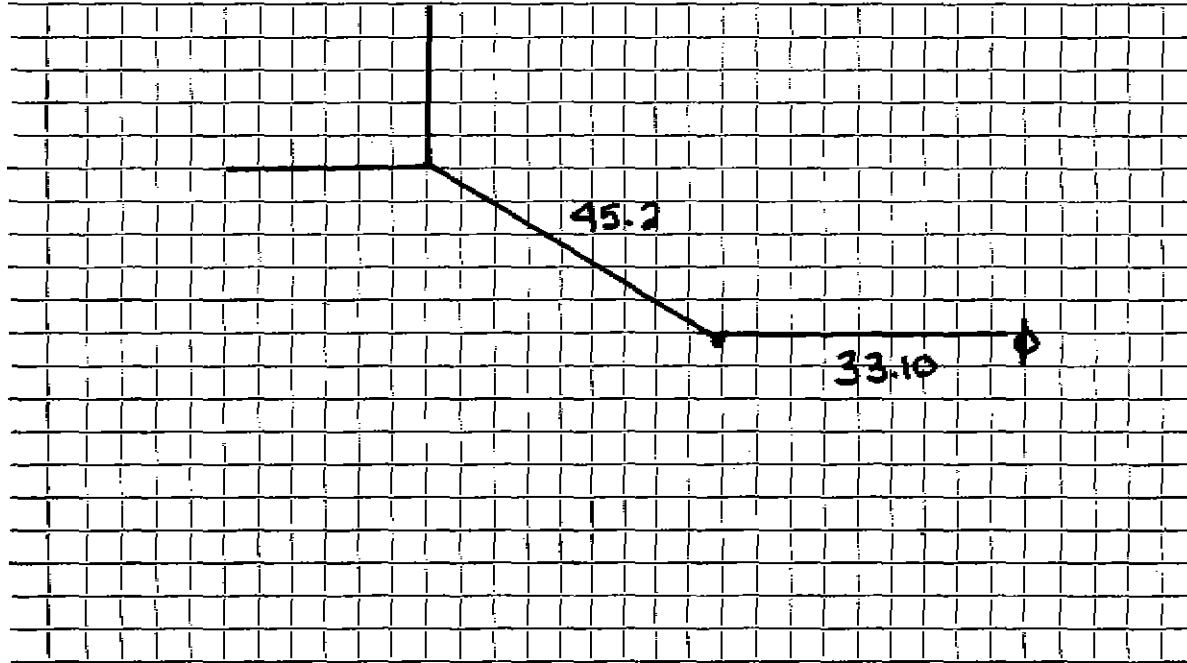

Connection made in Street. Work completed

Remarks:
.....
.....