

5420

WATER SERVICE RECORD

Name John J. Brennan

Service No. 93

Address #79 Cliffe Avenue

7598

Location

SEP 5 1967

Repair—Renewal—New Service *WO# 3258*


Date	Material	Amount	Total	Date	Amount
12/6/66	Labor	21.98		11-30-66	500.00
12/7/66	"	106.88		9-5-67	44.31
12/8/66	"	106.88	235.74		455.79
	10% O.H.	23.57	259.31		
	136' 3/4" Copper Pipe		107.44		OUTSIDE
	1 Wheel Valve		9.30	9'	3/4" Copper Tubing
	4 Unions		7.24	1	5/8" Copper Adapter
	1 Yd. Loam		3.00	1	3/4" C x 3/4" C Curb Cock
	8 Hr. Truck		24.00	1	Box & Rod
	7 Hr. Backhoe @6.50		45.50		
			455.79		

DATE _____

TOWN OF LEXINGTON — BOARD OF PUBLIC WORKS

WATER DIVISION

Sketch of Service Here

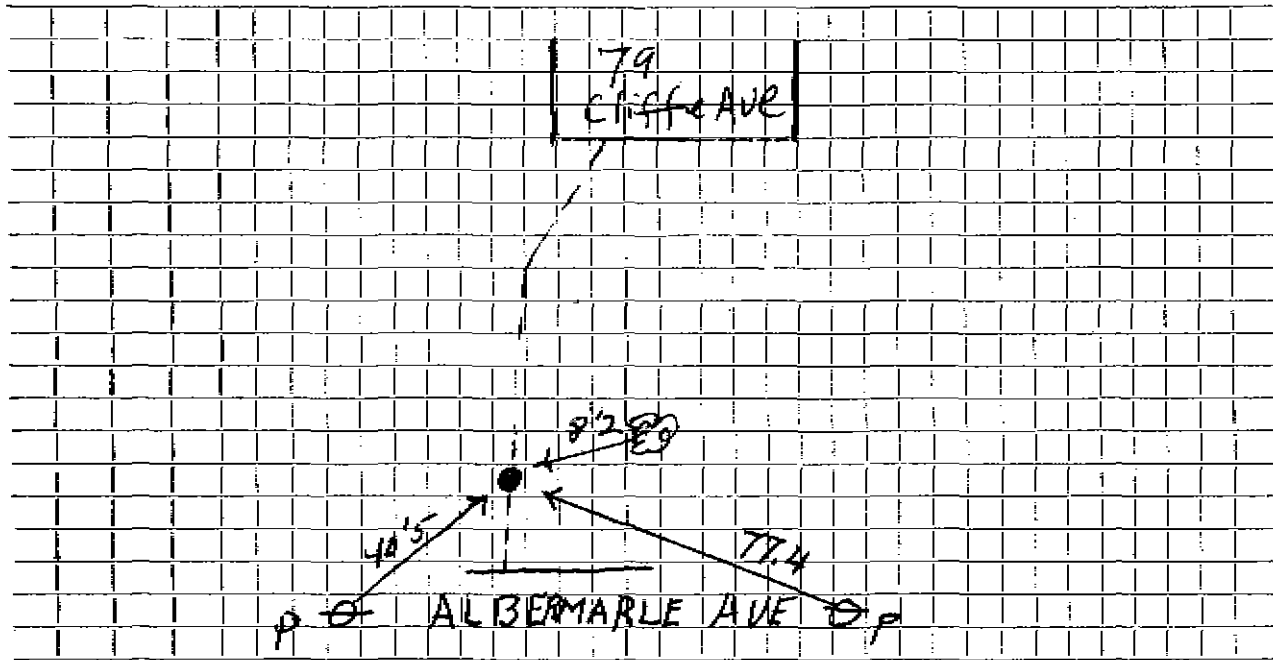

Connection made in ALBERMARLE AVE Street. Work completed

Remarks:
.....
.....