

WATER SERVICE RECORD

Name _____ Service No. _____

Address HSE #82 CLIFFE AVE

Location _____


Repair—Renewal—New Service

Date	Material	Amount	Total	Date	Amount
8-10-77	36 ft - 3/4"	\$5.00	\$180.00		
	COPPER @				
	Tied into existing service				
				3/4 CORP	
				3/4 CURB	
				BOX & ROD	

DATE 8/14/77

TOWN OF LEXINGTON — BOARD OF PUBLIC WORKS
WATER DIVISION

Sketch of Service Here

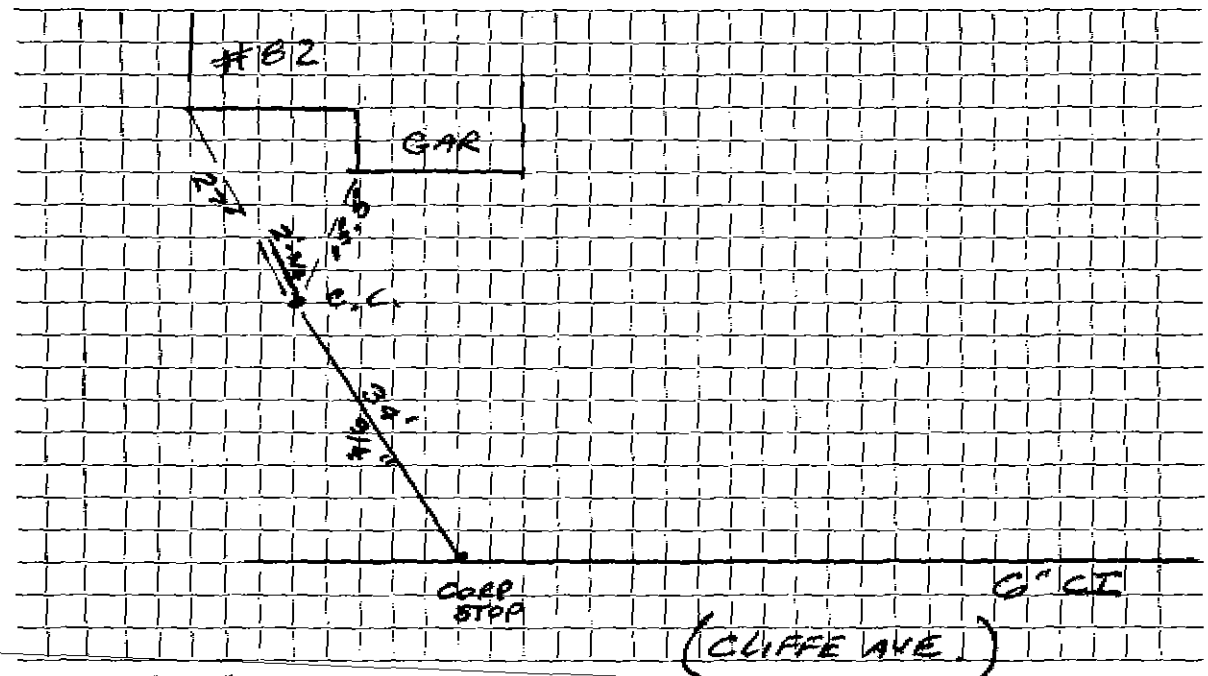

Connection made in St. As. Ave. Street. Work completed

Remarks: Previous tried to use Mts. Ave. End
no charge to use this service to house
charged if used for empty lot