




DATE 8/10/77

TOWN OF LEXINGTON - BOARD OF PUBLIC WORKS  
WATER DIVISION

Sketch of Service Here

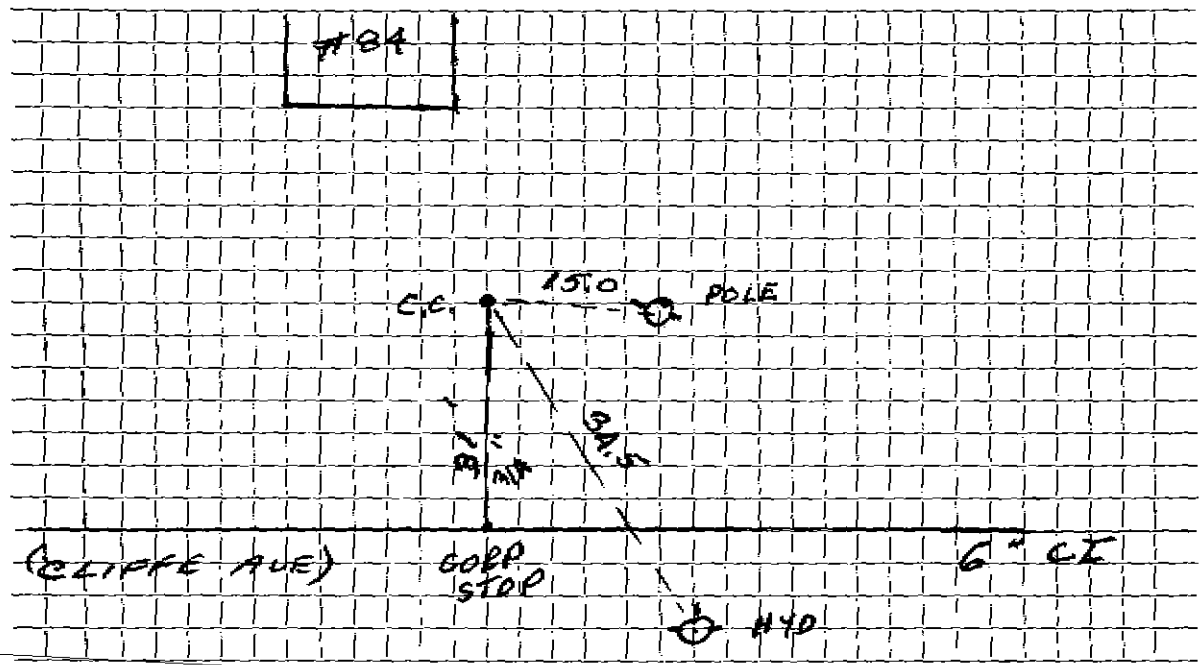

Connection made in CLIFFE AVE Street. Work completed .....

Remarks: Work completed on 8/10/77  
No charge to user. The service to user  
charged. sh. used. by user.