9.8.M.1501	٥
Name	

WATER SERVICE RECORD

Service No.

VACANT LOT #85 CLIFFE AVE Address

Location


Repair—Renewal—New Service							
Date	Materia:	Amount	Total	Date	Amount		
		Ţ					
		· ·					
		<u> </u>					
	<u> </u>	_					
		· · · · · · · · · · · · · · · · · · ·	<u> </u>	!			
		<u> </u>	 				
	· 	<u> </u>					
	· -	- -	· 				
·			-				
 			<u> </u>				
			+	<u> </u>			
	i			· i			
				1			
·		<u> </u>		<u>i</u>	- !		
	:]	ļ !	_	į l		

DATE 8/8/17

TOWN OF LEXINGTON - BOARD OF PUBLIC WORKS

WATER DIVISION

Sketch of Service Here

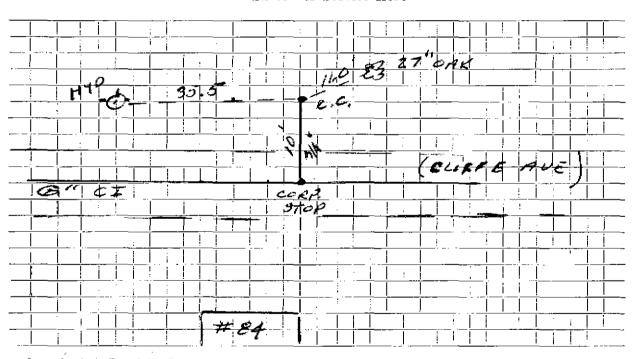

Connection made in	Work completed
Remarks:	***************************************