


DATE 8/11/77

TOWN OF LEXINGTON - BOARD OF PUBLIC WORKS

WATER DIVISION

Sketch of Service Here

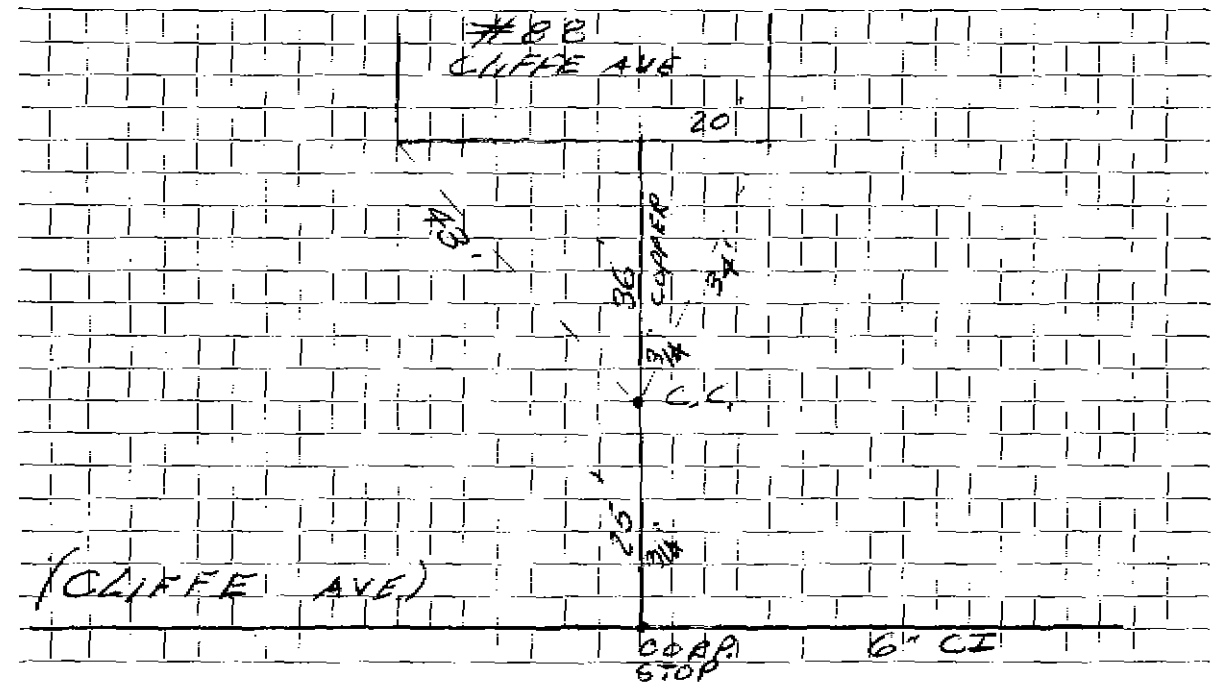

Connection made in CLIFFE AVE Street Work completed

Remarks:
.....
.....