Name

WATER SERVICE RECORD

Service No.


Location Repair—Renewal—New Service									
Date		Material	Amount	Total	. 	Date	Amount		
	! - -`	12 12 13 15		_	<u> </u>		<u> </u>		
			<u> </u>		 - 	· - 	-		
	\	7111	!	'! 	 				
5-11-48	<u> </u>	3/4" Copper;	ļ		!		 -		
	ļ	 	- -	<u>i</u>	 	_			
	i	·	<u></u> -	_ <u>"</u>			+		
-				-	╀─╾╫ ∶				
			 !	 	†	. _			
		L							
	! 	 	! 	 	' ! 				
	<u> </u>	İ	<u> </u>	<u> </u>	<u> </u>	-	1		
	 	 	 	_ j	 	· · · · · · · · · · · · · · · · · · ·	<u> </u>		
	i	! 	· 	ļ 	 	<u>!</u>	'		
			<u> </u>			-	 		
	- 	 	ļ _ <u>_</u> <u>!</u>		<u> </u>	- 	+		
	·		 +- 	 -	↓ ₩	<u>·</u>			
_ _	i			——————————————————————————————————————	 				

D	A	т	E	_
---	---	---	---	---

TOWN OF LEXINGTON - BOARD OF PUBLIC WORKS

WATER DIVISION

Sketch of Service Here

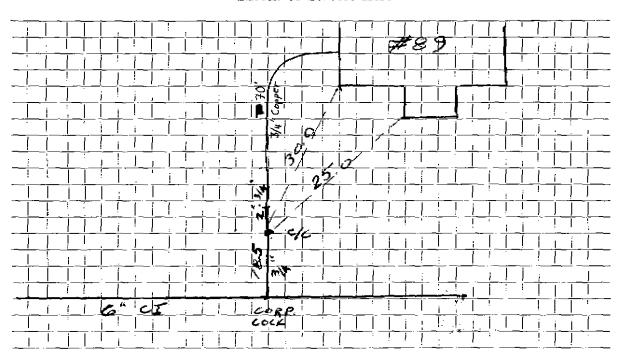

Connection made in Street.	Work completed
Remarks:	