


DATE 8/11/77

TOWN OF LEXINGTON -- BOARD OF PUBLIC WORKS
WATER DIVISION

Sketch of Service Here

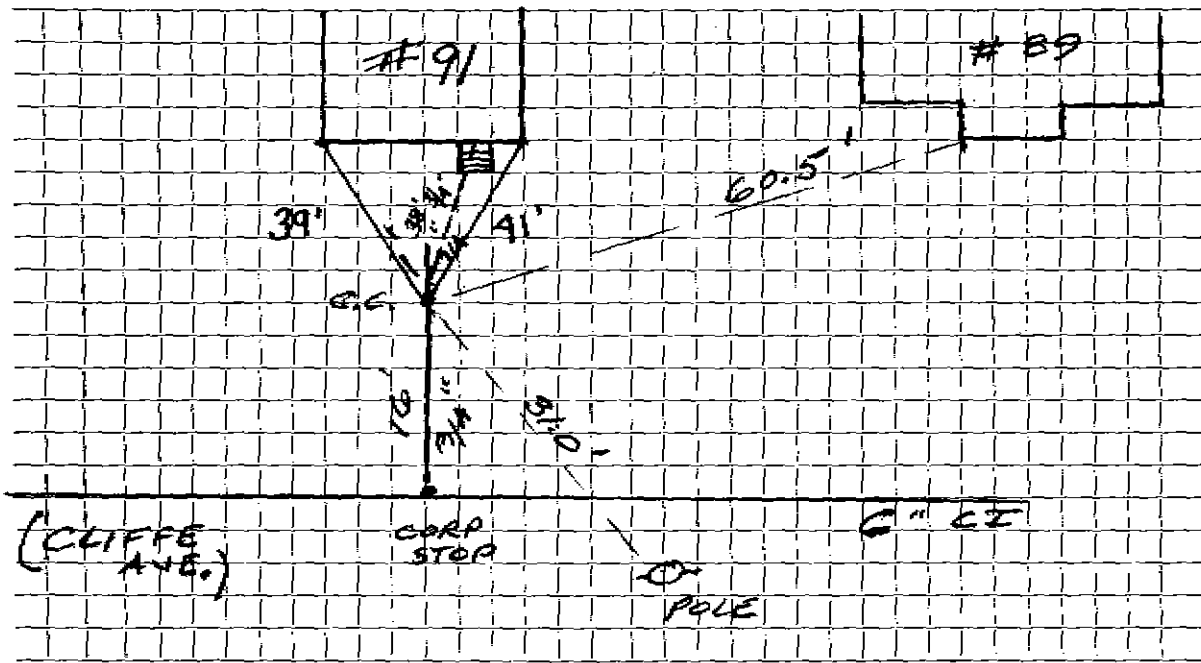

Connection made in Cliffe Ave. Street. Work completed

Remarks:
.....
.....