

WATER SERVICE RECORD

Name

Service No.

Address CLIFFE AVENUE - 2" C.L. PIPE IN STREET FROM

Location CUMMINGS AVE. TO HOUSE #78

~~Repair - Renewal - New Service~~ 2" KILLED - RELIVEING

Date	Material	Amount	Total	Date	Amount
					<u>NON CHARGE</u>
				7/24/53 Labor	99 25
				360' - 2" C.L. pipe @ .86	309 60
	TRENCH DUG BY OWNERS			40' - 1" copper tubing @ .3997	15 99
				4' - 1" C. corp-cock @ 5.61	22 44
				2 - 3/4" C x 3/4" C. curb-cock @ 4.67	9 34
				1 - 2" Mueller Gate valve	19 15
				1 - 1" C x 2" I. 4 way branch	19 38
				2 - 2" CL nipples 6" long @ .45	90
				4 - 2" x 1" L.L. tees @ 2.13	8 52
				1 - 2" x 1 1/4" L.L. red. couplings	1 29
				1 gate box	14 25
				2 hrs. Littlefield shovel @ 7.50	15 00
				2 hrs. Hough loader @ 3.00	6 00
				2 hrs. trucking @ .75	1 50
					542 61

DATE _____

TOWN OF LEXINGTON — BOARD OF PUBLIC WORKS

WATER DIVISION

Sketch of Service Here

A large rectangular area filled with a grid of small squares, intended for drawing a sketch of service.

Connection made in Street. Work completed


Remarks:
.....
.....

DATE _____

TOWN OF LEXINGTON — BOARD OF PUBLIC WORKS

WATER DIVISION

Sketch of Service Here

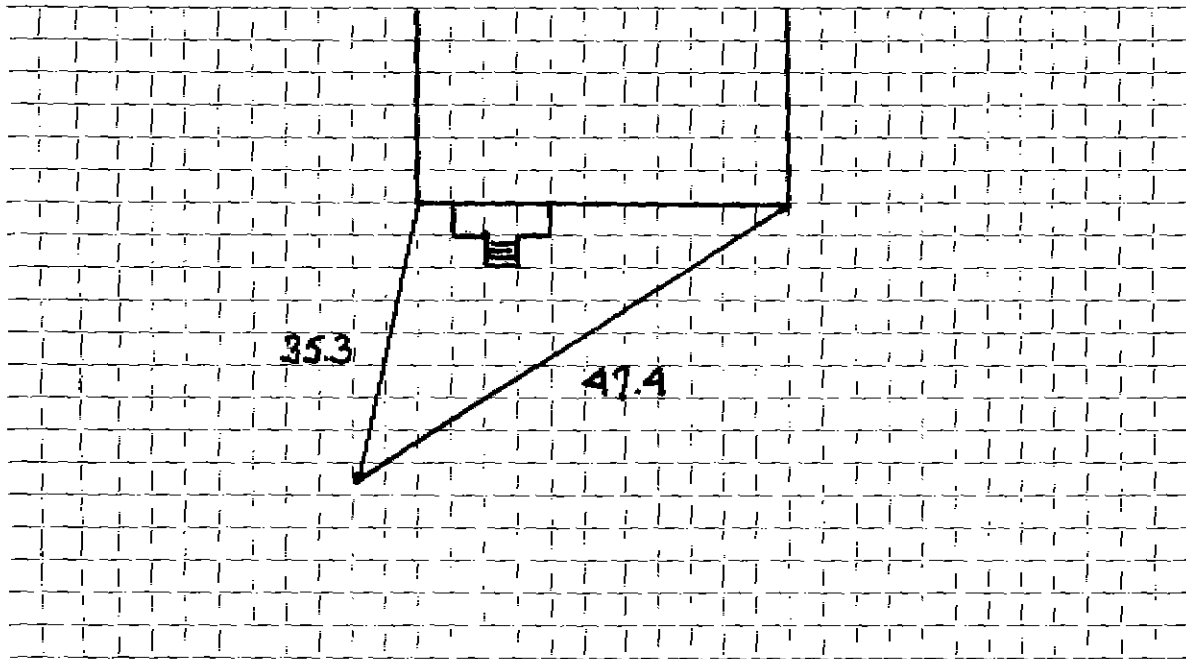

Connection made in Street. Work completed

Remarks:
.....
.....