


Date: May, 2023

TOWN OF LEXINGTON - BOARD OF PUBLIC WORKS
WATER DIVISION

SKETCH OF SERVICE HERE

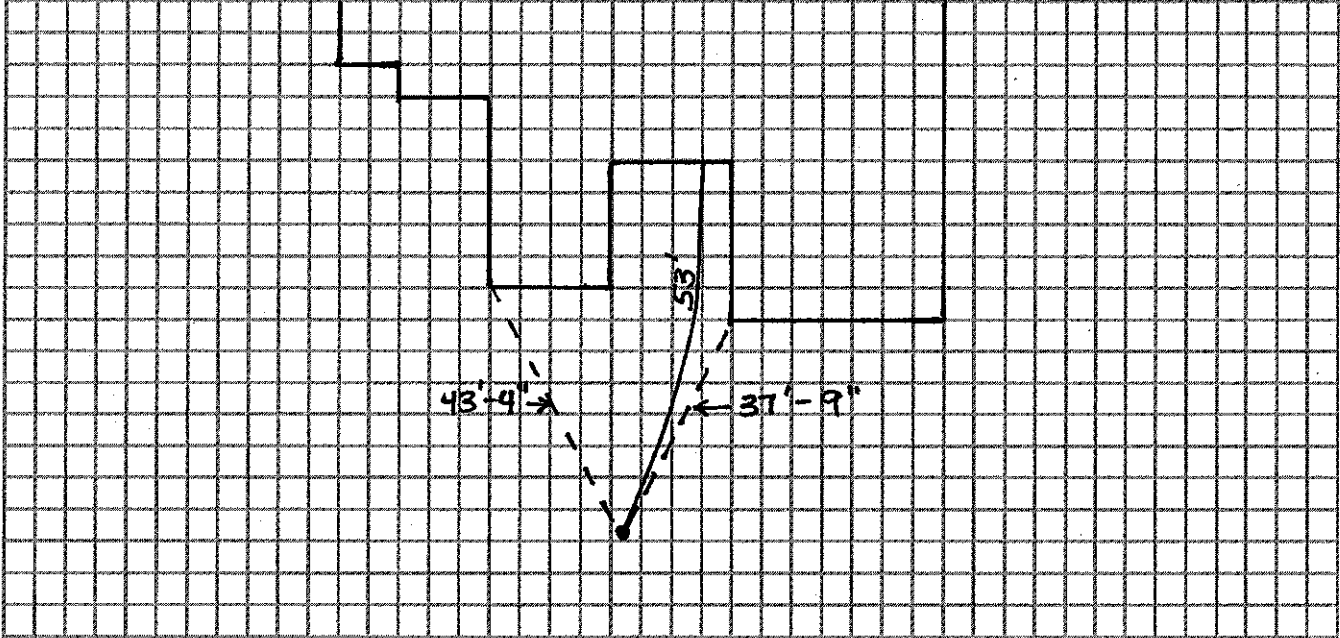

Connection made in: _____ Street. Work completed: _____

Remarks: _____