

WATER SERVICE RECORD

6771

Name Michael Saulich

Service No. 4

Address 4 Coach Road

Old

Location (mailing address) 18 Stage Coach Rd., Bedford

~~REPAIRS~~ - New Service


WO # 589

Date	Material	Amount	Total	Date	Amount	
3-16-73	Labor	51 36		3-8-73	Deposit	200 00
3-29-73	"	14 74	66 10	5-29-73	Refund	13 38
	10% O.H.		6 61			184 62
	18' - 1" pipe @.99		17 82			
	1 - 1" corp.		10 66			
	1 - 1" curb cock		14 43			
	Box and Rod		7 50			
	½ ton cold patch		2 00			
	1 hour truck		3 00			
	2 hours shovel @6.50		13 00			
	Hot top patching 7 sq. ft. @6.50		45 50			
			186 62			
3-19-73	117' 1" copper					

DATE _____

TOWN OF LEXINGTON — BOARD OF PUBLIC WORKS
WATER DIVISION

Sketch of Service Here

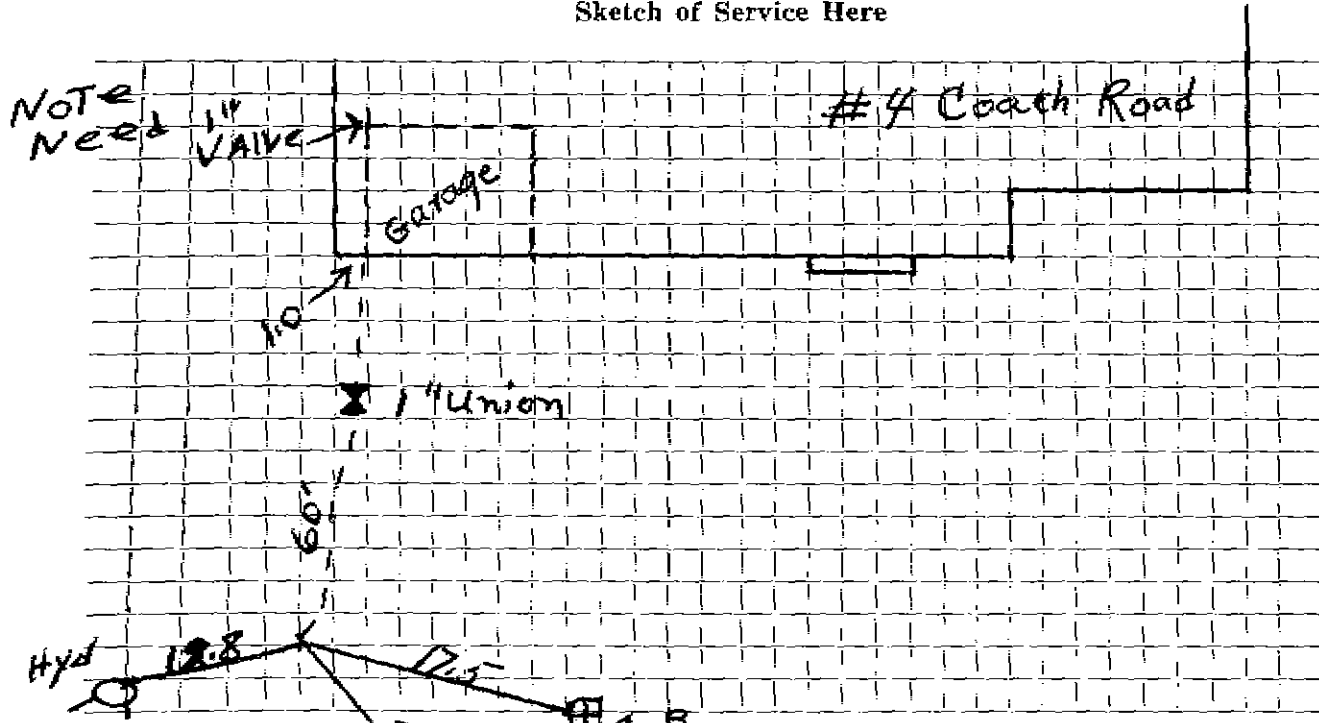

Connection made in Work completed

Remarks:
.....
.....