

Name James C. Powers (Builder)  
 Address 77 Laposia Street, Woburn, Mass.  
 10 Colony Road

Service No. ~~##~~ 604  
 # 898-824

Location 10 Colony Road

Kind of Pipe Size Size of Main  
 Repair—Renewal—New Service Location

Date  
 1941

Date	Material	Amount
May 7,	3 hrs. @ 60¢	1 80
Jan 9/41	10% Overhead,	18
	54' 3/4" Copper tubing @ 19¢	10 26
	1 3/4" C.x 1/8" I. W.H.S. & W.	2 25
	Trucking, 2 hrs. @ 75¢	1 50

Total
15 99

Date

April 8, 1941 Deposited  
 June 14, 1941 Refunded

Amount

24 00
8 00
15 99

Labor

DATE 12/1/21

# TOWN OF LEXINGTON—BOARD OF PUBLIC WORKS

## WATER DIVISION

The undersigned applies for a supply of water at No. 16 Colony Rd. St. and hereby agrees to comply with the rules and regulations as now, or at any future time, established by the Board of Selectmen.

Am't. of Estimate \$                     

Owner                     


Am't. Paid \$                     

Address                     

Builder                     

*77-3314*  
*Jul 13 3314*

*Custom date* Sketch of Service Here

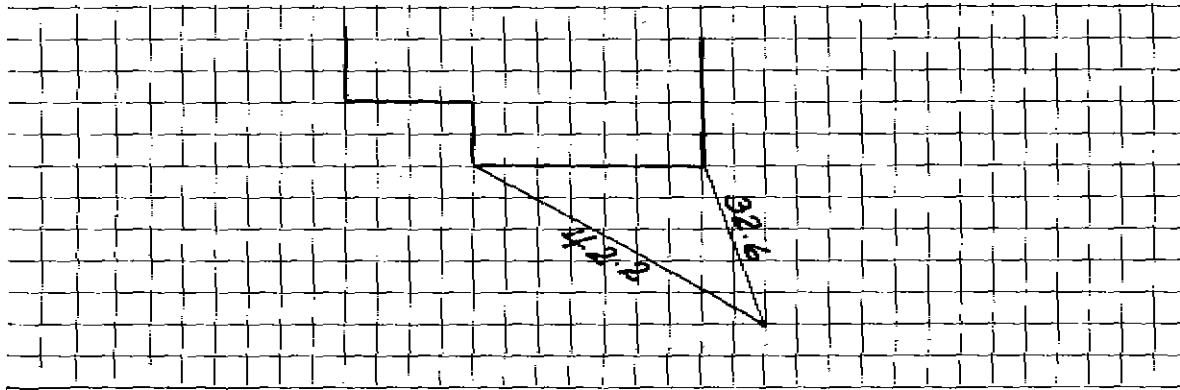

Connection made in                      Street.

Work completed                      19

Remarks: