

Name R.H. Stevens

8874
Service No. 44

Address Utica Street, Lexington,
17 Colony Road

Location 17 Colony Road

Kind of Pipe CURB SHO'S OFF RIGHT
Size 8

Size of Main

Repair ~~Excavate New Service~~

Location

Date	Material	Amount	Total	Date	Amount
1939					
Sept. 9,	1½ hrs. @ 55¢	83		September 9, 1939	
<i>Sept. 10</i>	1½ " @ 65¢	98	1 81	<i>Paid</i>	6 59
	10% Overhead		18		
	6' 3/4" Copper tubing @ 15¢		90		
	2 3/4" C.Unions (3 part)		88		
	1 box & rod		1 70		
	1½ hrs. trucking @ 75¢		1 12		
			6 59		
	Labor				

Hadley Press, Inc., Lexington

TOWN OF LEXINGTON — BOARD OF PUBLIC WORKS

WATER DIVISION

The undersigned applies for a supply of water at No. _____ St. and hereby agrees to comply with the rules and regulations as now, or at any future time, established by the Board of Selectmen.

Am't. of Estimate \$ _____

Owner _____


Am't. Paid \$ _____

Address _____

Builder _____

Curb Slops OFF Right

Sketch of Service Here

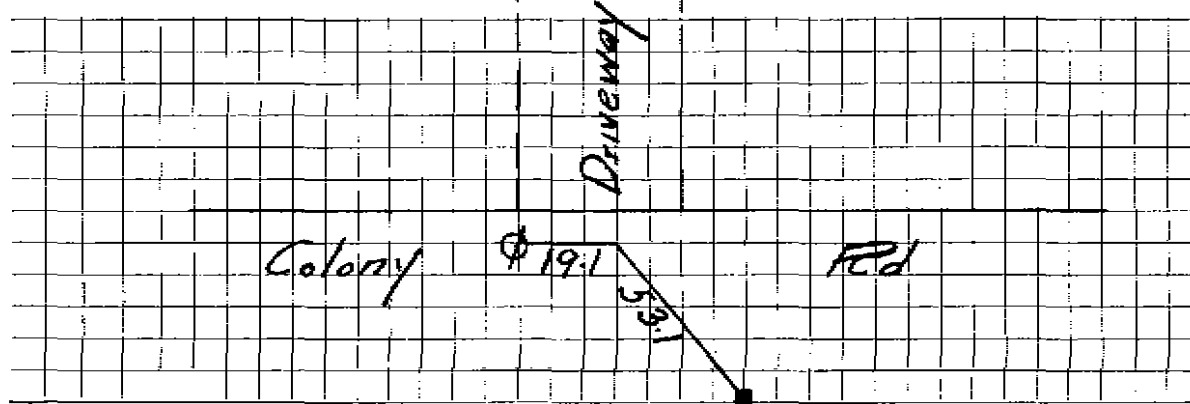

Connection made in _____ Street.

Work completed _____ 19

Remarks: