

Name Miss Millicent Taylor, Owner-(M.B.Judkins, Builder)

Service No. ~~60~~ 605

Address Bedford, Mass.
18 + 19 Colony Road

Locatic Lot 18 & 19, Colony Road #17

Kind of Pipe Size Size of Main

~~Repair & Renewal~~ - New Service

Location

Date	Material	Amount	Total	Date	Amount
P. 12-22-31 for 83.25	111' 3/4" Copper Pipe @.20	22 20			
	2 3/4" C. to C. Unions @.70-	1 40			
	1 3/4" C to I Ell	1 10			
	1 1" Br. Sp. Nip.	25			
	1 S & W	3 00			
	Trucking	75	28 70		
11/27/31	7 Hrs. Labor @.55	3 85			
	2 " " @.60	1 20	5 05		
	15% Overhead		76		
	Labor		34 51		
CHARGE	111' @ .75	\$83 25	\$83 25	Feb 27 1932 - Cash	83 25

J Hadley Press, Inc. Lexington

French Aug

DATE Nov. 10, 1931

TOWN OF LEXINGTON—BOARD OF PUBLIC WORKS

WATER DIVISION

The undersigned applies for a supply of water at ^{Lot} No. 18 & 19, Colony Rd. ^(old Francis St.) St. and hereby agrees to comply with the rules and regulations as now, or at any future time, established by the Board of Selectmen.

Am't. of Estimate \$ _____

Owner Miss Millicent Taylor


Am't. Paid \$ _____

Address Bedford, Mass.

Builder W. B. Judkins

By W. B. Judkins, (Contr.)

Sketch of Service Here

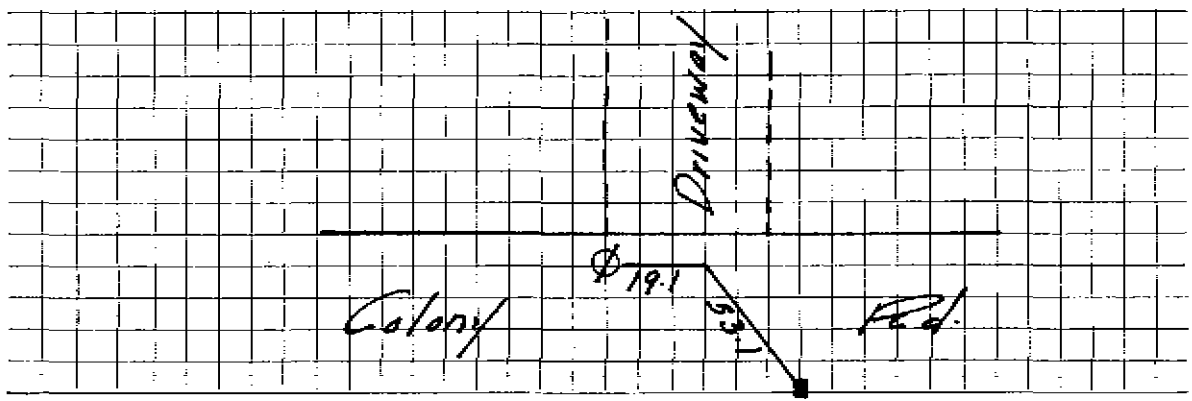

Connection made in _____ Street.

Work completed _____ 19

Remarks: