

Name George Grant
Address 24 Colony Road

Service No. 80 3159
#6251

Location

Kind of Pipe

Size

Size of Main

Repair—Renewal—New Service

Location

Date

Material

Amount

Total

Date

Amount

July 13, '46	Labor	90	90
	10% Overhead		09
	31' - $\frac{3}{4}$ " Copper Tubing S.1911	5	92
	1 - $\frac{3}{4}$ " C x $\frac{1}{2}$ " I.W.H. Stop & Waste	2	82
	Trucking 1 hr. @ .75		75
			<hr/> 10 48

Trench Dug By Owner

Labor

July 13, '46	Deposited	15 00
July 13, '46	Spent	<hr/> 15 00
	Non-Charge	10 48
July 13, '46	Labor	7 70
	15' - $\frac{3}{4}$ " Copper Tubing S.1911	2 59
	1 - $\frac{3}{4}$ " C Corp-cock	2 70
	1 - $\frac{3}{4}$ " C x $\frac{1}{2}$ " C Carb-cock	3 30
	1 - Box & Rod	1 65
	1 - $\frac{3}{8}$ " Straight Tail Piece	90
	2 - $\frac{3}{8}$ " Offset Tail Piece	90
	Trucking 1 hr. @ .75	<hr/> 75
		20 19

DATE _____

TOWN OF LEXINGTON—BOARD OF PUBLIC WORKS

WATER DIVISION

The undersigned applies for a supply of water at No. _____ St. and hereby agrees to comply with the rules and regulations as now, or at any future time, established by the Board of Selectmen.


Am't. of Estimate \$ _____

Owner _____

Am't. Paid \$ _____

Address _____

Builder _____

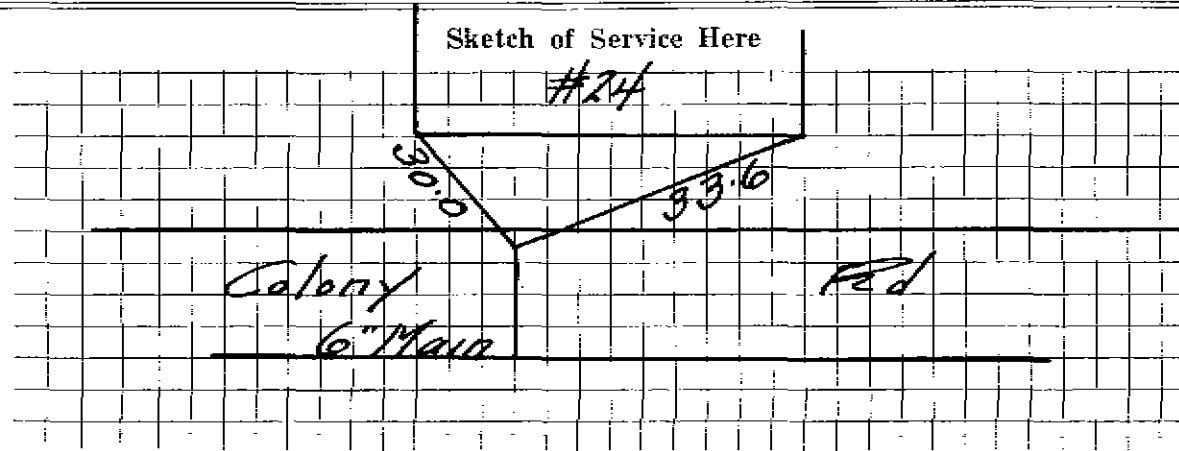

Connection made in _____ Street.

Work completed _____ 19

Remarks: