			Water Service Record				
Name	· · · · · · · · · · · · · · · · · · ·						
Address	26 Colony	Rd					

Service No.


Location

Repair - Renewal - New Service

							
Date	Material	Amount	Total	Date	<u> </u>		Amount
11/17/21	I"type k copper						
	1" curb stop						
	pour right						
	open right camb. brass				***************************************		
	3/4"to/" union						
		•					
 <u> </u> -							
							· ·
·							
						· <u></u>	10 10 10 10 10 10 10 10 10 10 10 10 10 1
							!
	•						

TOWN OF LEXINGTON - BOARD OF PUBLIC WORKS **WATER DIVISON**

SKETCH OF SERVICE HERE

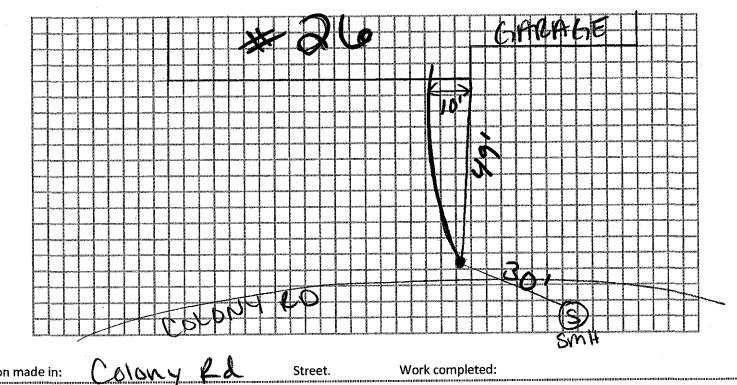

Connection made in:

Address Change from 34 Cdany to 24 Cdany.