

Name

Address 27 Colony Rd.

Service No. 607
#7776

Location 27 Colony Rd.

Kind of Pipe

Size

Size of Main

Repair—Renewal—New Service

Location

| Date | Material | Amount | Total | Date | Amount |
|------|----------|--------|-------|------|--------|
| | Labor | | | | |

Hudley Press, Inc., Lexington

DATE _____

TOWN OF LEXINGTON - BOARD OF PUBLIC WORKS

WATER DIVISION

The undersigned applies for a supply of water at No. _____ St. and hereby agrees to comply with the rules and regulations as now, or at any future time, established by the Board of Selectmen.

Am't. of Estimate \$ _____

Owner

Arthur Yaker


Am't. Paid \$ _____

Address

27 Colony Rd.

Builder _____

Sketch of Service Here

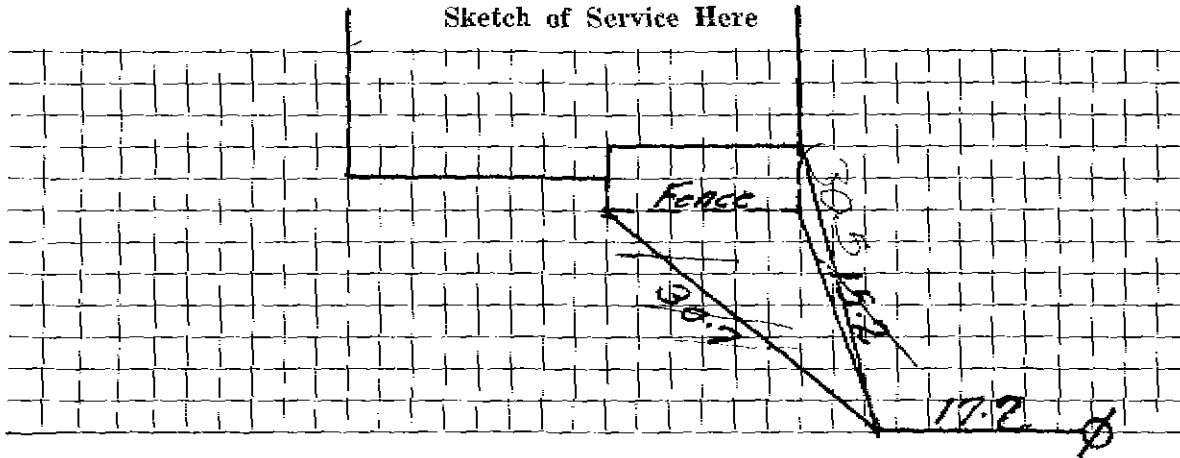

Connection made in _____ Street.

Work completed _____ 19

Remarks: