

Name Charles H. Oveily, (Check from Merle Miller)
 Address 29 Colony Rd.,
 29 Colony Rd. Lex.

4873
 Service No. ~~51~~ 608

Location 29 Colony Rd.

Kind of Pipe

Size

Size of Main

~~Repair-Renewal~~ - New Service

Location

Date	Material	Amount	Total	Date	Amount
1937					
Oct. 16	2 hrs. @ 60¢	1 20	1 20	Oct. 18, 1937	27 00
	10% overhead		12	Oct 20 1937	2 00
	50' 3/4" Cop. Tubing @ 25¢		12 50		
	1 3/4" S. & W.		3 75		
	1 3/4" U. Union		1 10		
	2 hrs. trucking @ 75¢		1 50		
			<u>20 17</u>		
	Flat Rate:				
	30' @ 50¢		25 00		
	Labor				

Hadley Press, Inc., Lexington

DATE 7/11/27

TOWN OF LEXINGTON—BOARD OF PUBLIC WORKS

WATER DIVISION

The undersigned applies for a supply of water at No. 217A Davis Ave and hereby agrees to comply with the rules and regulations as now, or at any future time, established by the Board of Selectmen.

Am't. of Estimate \$ 25


Owner Charles H. Presley

Am't. Paid \$ _____

Address R 17A Davis Ave
Brookline Mass.

Builder _____

Sketch of Service Here

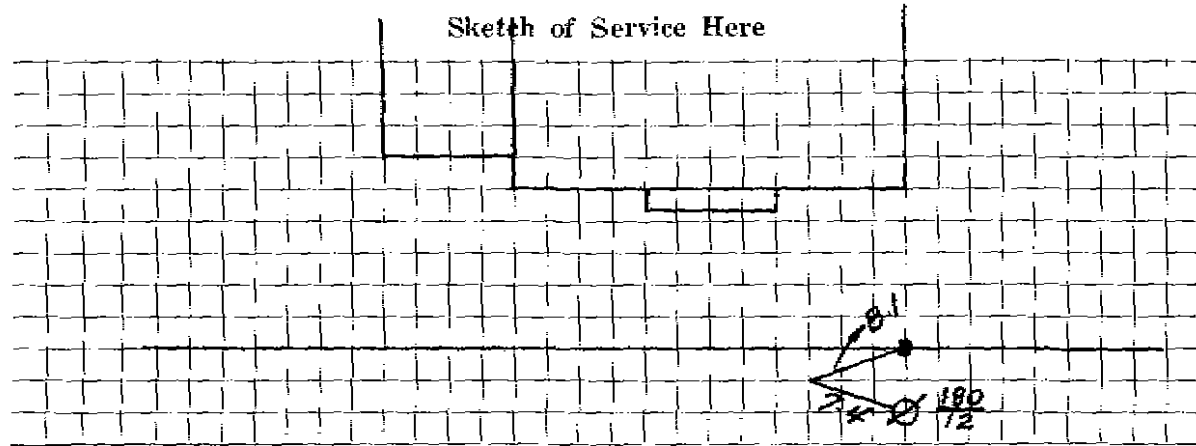

Connection made in _____ Street. Work completed _____ 19

Remarks: