

Name W. P. Grush

Address 32 Colony Road

Lexington, Mass/

2400-1
Service No. 130

Location

Kind of Pipe

Size

Size of Main

~~Repair~~ ~~Renewal~~ New Service

Location

Date	Material	Amount	Total	Date	Amount
Oct. 14, '48	Labor	10 95	10 95	Oct 6 '48	75 00
	10% Overhead		1 10		26 50
	42'-3/4" Copper Tubing @ .255		10 71		48 66
	1-3/4" C x 1/2" I.W.H. S & W		3 15	Oct. 14, '48	Labor
	2 hrs. Littlefield Shovel		14 00		3 00
	1 hr. Trucking		75	12'-3/4" Copper Tubing @ .255	3 06
	Patching 8 x 3		8 00	1-3/4" C. Corp-cock	3 00
			48 66	1-3/4" c x 3/4" C. Carb cock	3 68
				1- Box & Rod	3 55
				1 hr. Littlefield Shovel	7 00
				1-1/2" Offset Tail Piece	30
				1-3/4" Straight Tail Piece	30
				1 hr. Trucking	75
	Labor				24 64

DATE _____

TOWN OF LEXINGTON—BOARD OF PUBLIC WORKS

WATER DIVISION

The undersigned applies for a supply of water at No. _____ St. and hereby agrees to comply with the rules and regulations as now, or at any future time, established by the Board of Selectmen.

Am't. of Estimate \$ _____


Owner _____

Am't. Paid \$ _____

Address _____

Builder _____

Sketch of Service Here

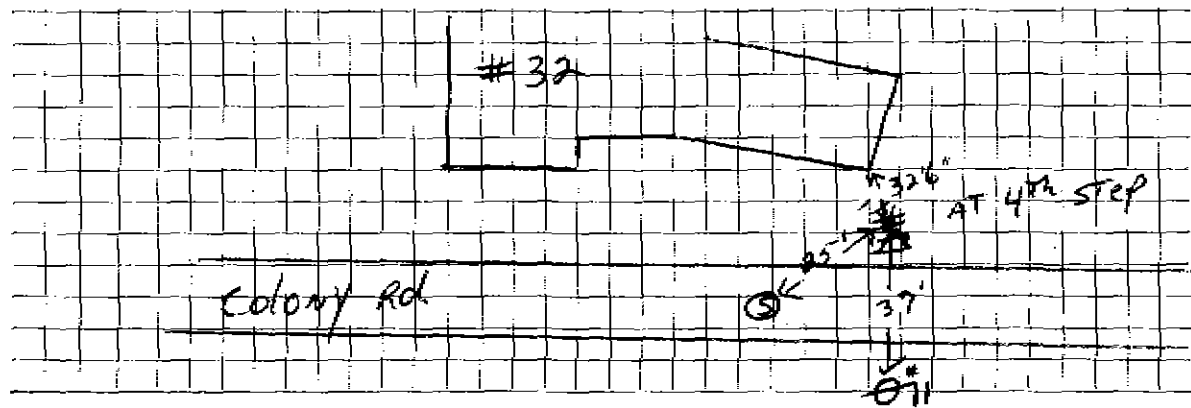

Connection made in _____ Street.

Work completed _____ 19

Remarks: